City of Prince George
HISTORY SHEET

003 901131

SHEET NUMBER **3412** **Roll Number**

Legal: LOT'S 7 BLOCK D.L. 913 PLAN 25558

Address: 1561 PAXTON PL.

Sanitary Connection: # SIZE 100 MM MATERIAL PVC INV. CONNECTED

Water Connection # SIZE 20 MM MATERIAL Copper METER CONNECTED

Storm Connection: # SIZE MATERIAL INV. CONNECTED

Cash Receipt No's: WATER SANITARY STORM

CURB FROM PROPERTY LINE PAVEMENT WIDTH

B.C. HYDRO SEE ENG. DWG. 2927 UNDERGROUND CONNECTION

B.C. TELEPHONE " " UNDERGROUND CONNECTION

INLAND GAS AS SHOWN.

Information Sheets:

Comments:
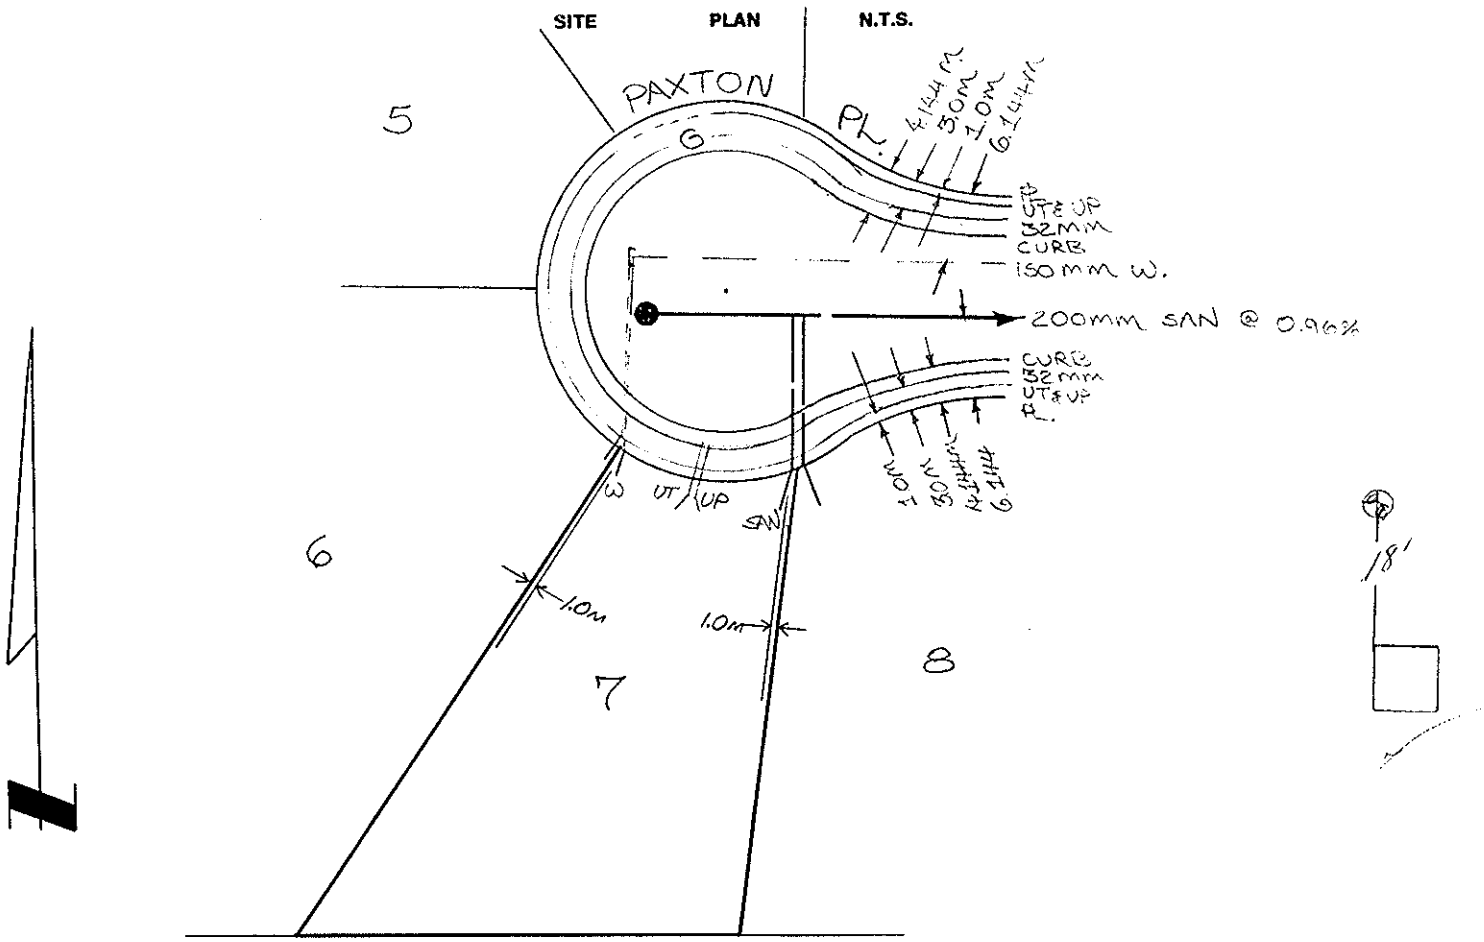
SITE PLAN N.T.S.