City of Prince George
HISTORY SHEET

SHEET NUMBER **7260** **Roll Number** 00396768

Legal: LOT'S Southwest 1/4 of Souteast 1/4 District Lot 2424. BLOCK D.L. PLAN

Address: Area West of Handling Road and Thomspon Road.

Sanitary Connection: # SIZE MATERIAL INV. CONNECTED

Water Connection # SIZE nil MATERIAL METER CONNECTED

Storm Connection: # SIZE MATERIAL INV. CONNECTED

Cash Receipt No's: WATER SANITARY STORM

CURB FROM PROPERTY LINE PAVEMENT WIDTH

B.C. HYDRO UNDERGROUND CONNECTION

B.C. TELEPHONE UNDERGROUND CONNECTION

INLAND GAS

Information Sheets:

Comments:

OWNER: Safeway Construction &
Montalco Kitchen Cabinets Ltd
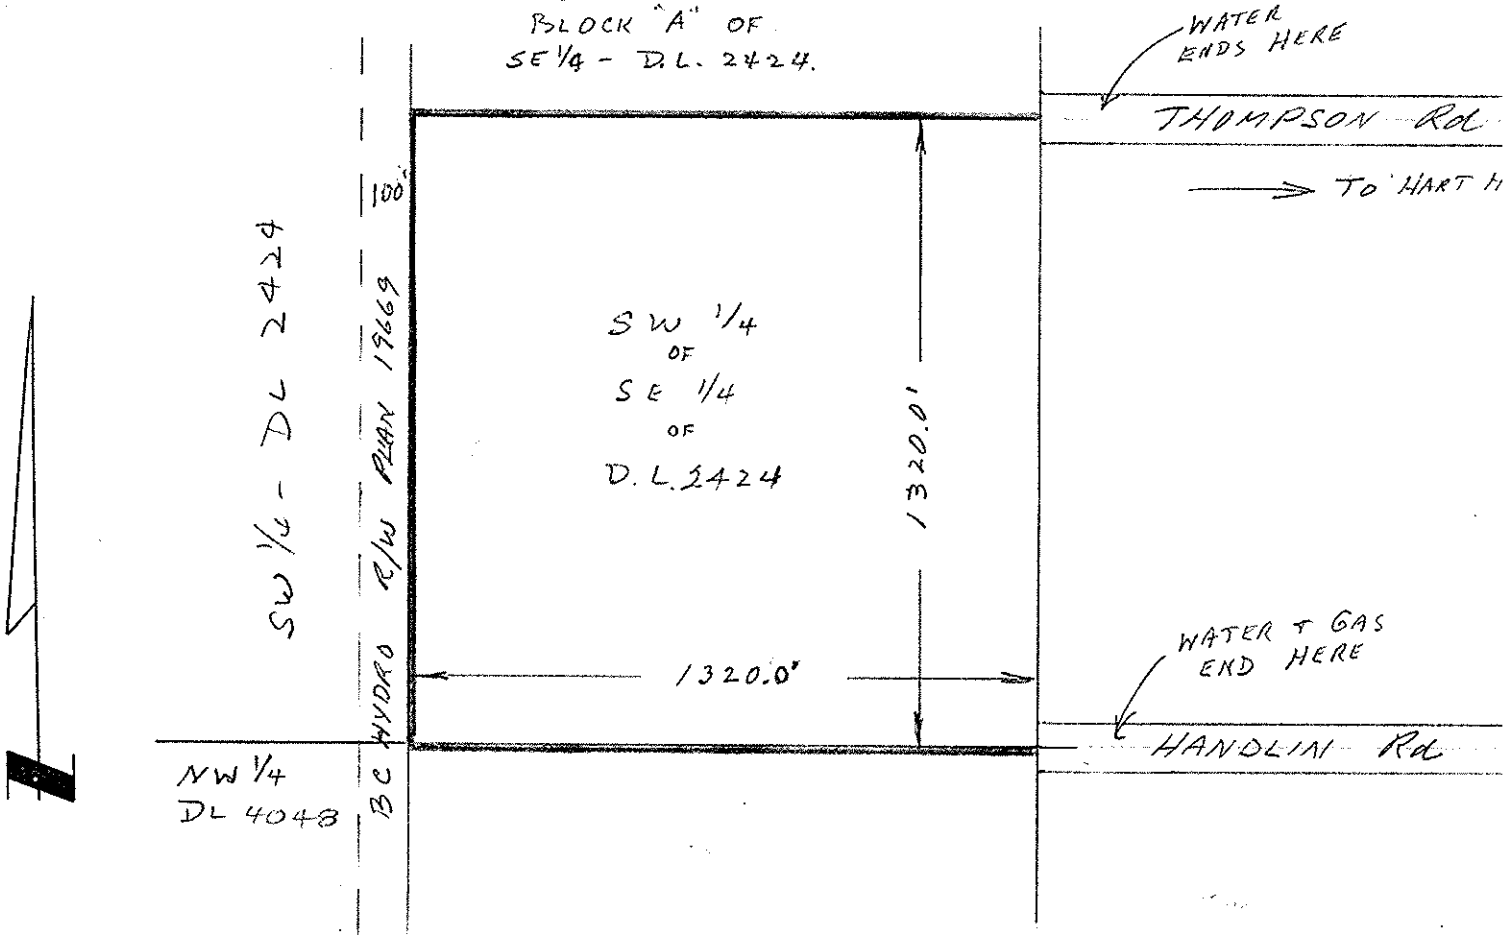
SITE PLAN N.T.S.