City of Prince George
HISTORY SHEET

PREPARED BY GRC

SHEET NUMBER **4983** **Roll Number** 004006

Legal: LOT'S 4 BLOCK D.L. 4050 PLAN 27403

Address: 4649 NEW GLEN CRT

Sanitary Connection: # SIZE 100 mm MATERIAL P.V.C. INV. 603.93 CONNECTED

Water Connection # SIZE 20 mm MATERIAL Cu METER CONNECTED

Storm Connection: # SIZE MATERIAL INV. CONNECTED

Cash Receipt No's: WATER SANITARY STORM

CURB FROM PROPERTY LINE 5.0 m (ROLL CURB) PAVEMENT WIDTH 10.0 m

B.C. HYDRO UNDERGROUND CONNECTION U/G MIDLOT

B.C. TELEPHONE UNDERGROUND CONNECTION U/G MIDLOT

INLAND GAS 1.5 m OFFSET

THE INFORMATION CONTAINED HEREIN IS FOR INTERNAL USE ONLY. NOT TO BE RELIED UPON UNLESS CONFIRMED BY SITE INSPECTION AND/OR INVESTIGATION.

Information Sheets:

Comments: BENCH MARK - ELEVATION 606.386 m

H.S. N.W. CORNER NEW GLEN PLACE &

NORTH MEADOWS ROAD
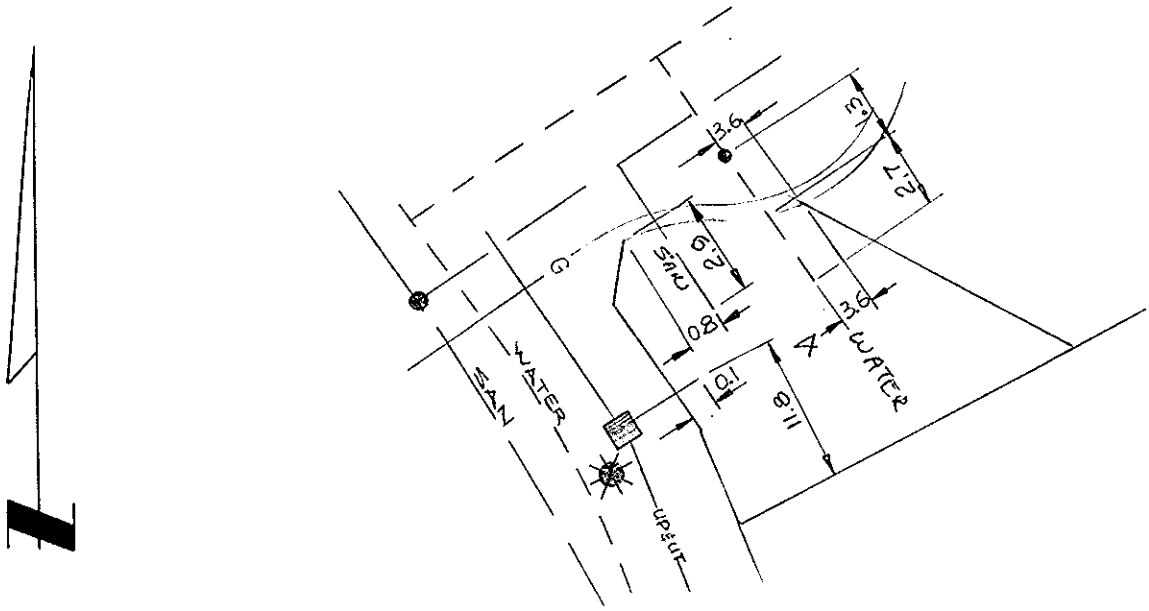
SITE PLAN N.T.S.