004067193
215
223
240
S

City of Prince George
HISTORY SHEET

SHEET NUMBER | **Roll Number**

Legal: LOT'S 1 TO 4 BLOCK 279 D.L. 343 PLAN 1268

Address: 1707 REDWOOD ST.

Sanitary Connection: # 2840 3039 SIZE 100 mm 100 mm MATERIAL A.C. A.C. INV. CONNECTED

Water Connection # SIZE 25MM MATERIAL Copper METER CONNECTED

Storm Connection: # SIZE MATERIAL INV. CONNECTED

Cash Receipt No's: WATER 8426 SANITARY STORM

CURB FROM PROPERTY LINE 4.877 PAVEMENT WIDTH

B.C. HYDRO O/H UNDERGROUND CONNECTION

B.C. TELEPHONE O/H UNDERGROUND CONNECTION

INLAND GAS AS SHOWN

Information Sheets:

Comments:
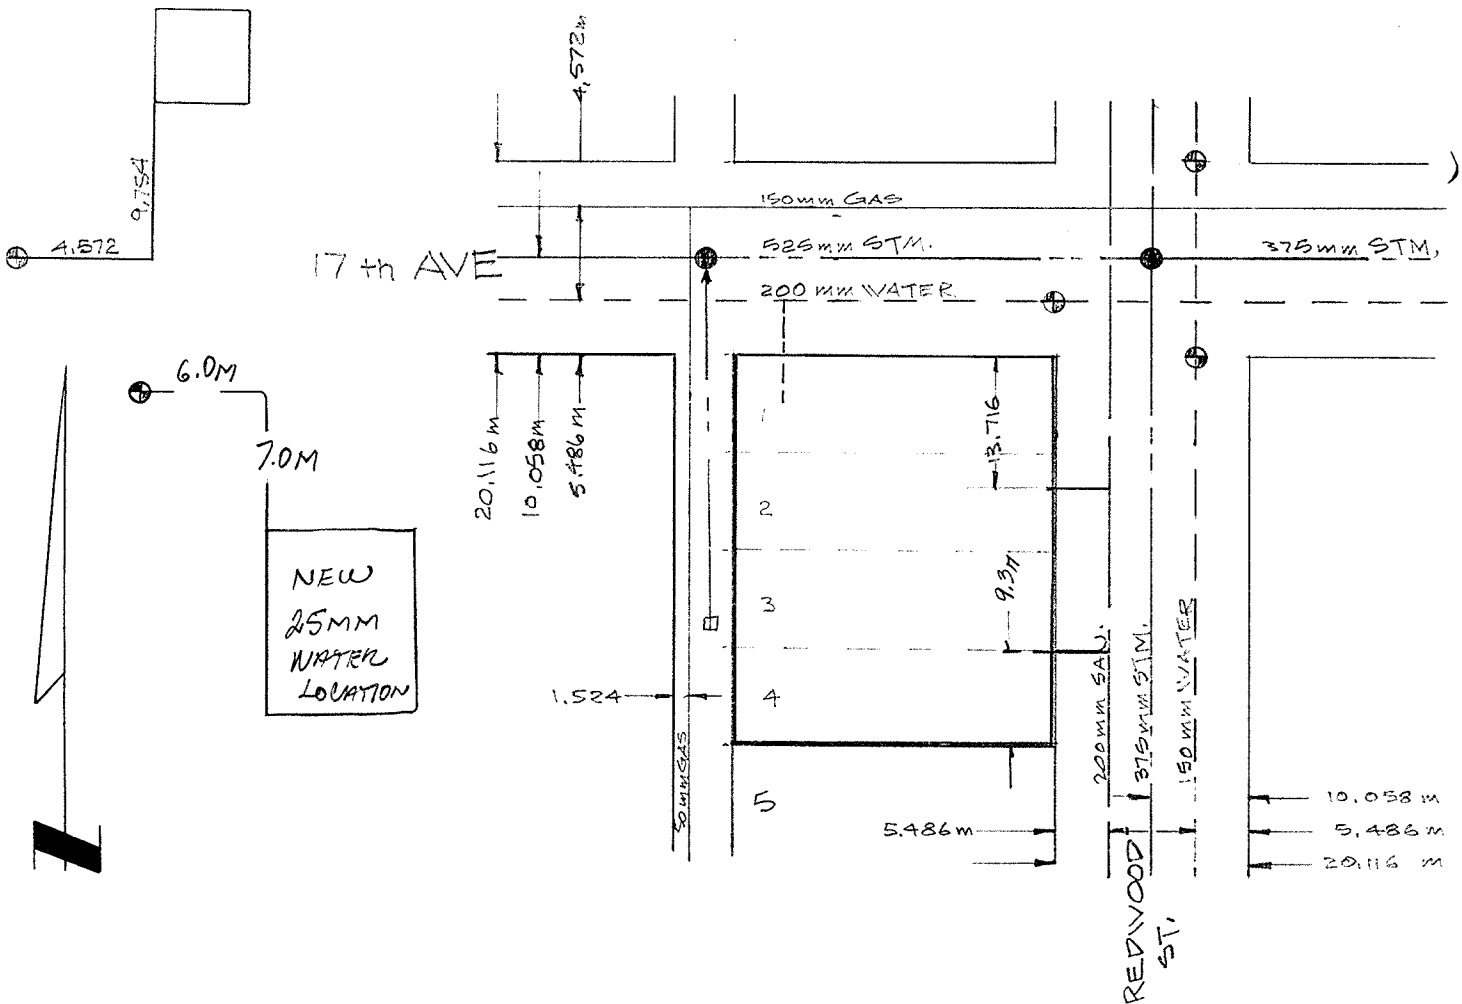
THE INFORMATION CONTAINED HEREIN IS FOR INTERNAL USE ONLY.
NOT TO BE RELIED UPON UNLESS CONFIRMED BY SITE INSPECTION AND/OR INVESTIGATION