City of Prince George
HISTORY SHEET

004674777

SHEET NUMBER 2099 **Roll Number**

Legal: LOT'S Pt Lot 11 BLOCK D.L. 4046 PLAN 11234 (20558

Address: 1850 CROFT RD.

Sanitary Connection: # 013407 SIZE 4" MATERIAL INV. 2309.67 CONNECTED

Water Connection # 6467 SIZE 3/4" MATERIAL COPPER METER CONNECTED

Storm Connection: # SIZE MATERIAL INV. CONNECTED

Cash Receipt No's: WATER SANITARY STORM

CURB FROM PROPERTY LINE PAVEMENT WIDTH

B.C. HYDRO UNDERGROUND CONNECTION

B.C. TELEPHONE UNDERGROUND CONNECTION

INLAND GAS

Information Sheets:

Comments:
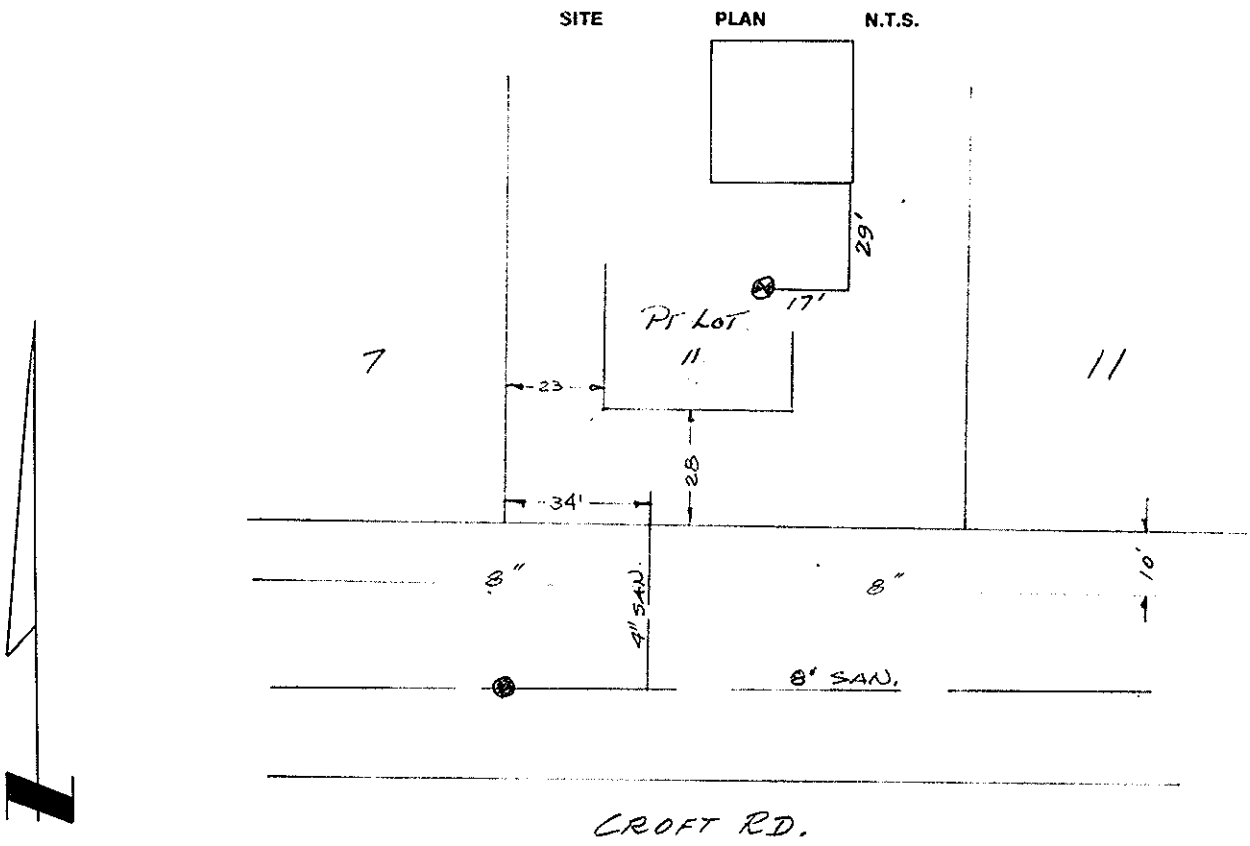
SITE PLAN N.T.S.