City of Prince George
HISTORY SHEET

SHEET NUMBER **1509** **Roll Number**

Legal: LOT'S 21 - 22 BLOCK 176 D.L. 343 PLAN 1268

Address: 1780 7th AVENUE

Sanitary Connection: # 5335 SIZE 4" MATERIAL A.C. INV. 1892.10 CONNECTED YES

Water Connection # 11249 SIZE 3/4" MATERIAL COPPER METER CONNECTED YES

Storm Connection: # SIZE MATERIAL INV. CONNECTED

Cash Receipt No's: WATER SANITARY STORM

CURB FROM PROPERTY LINE 16' PAVEMENT WIDTH 48'

B.C. HYDRO O.H. UNDERGROUND CONNECTION

B.C. TELEPHONE O.H. UNDERGROUND CONNECTION

INLAND GAS IN LANE ϕ 2" MAIN

Information Sheets:

Comments: BENCH MARK # 41-77 ELEVATION = 1898.67

H.S. N.E CORNER 7th AND PRINCE RUPERT

LEVEL BOOK # 177 P.33
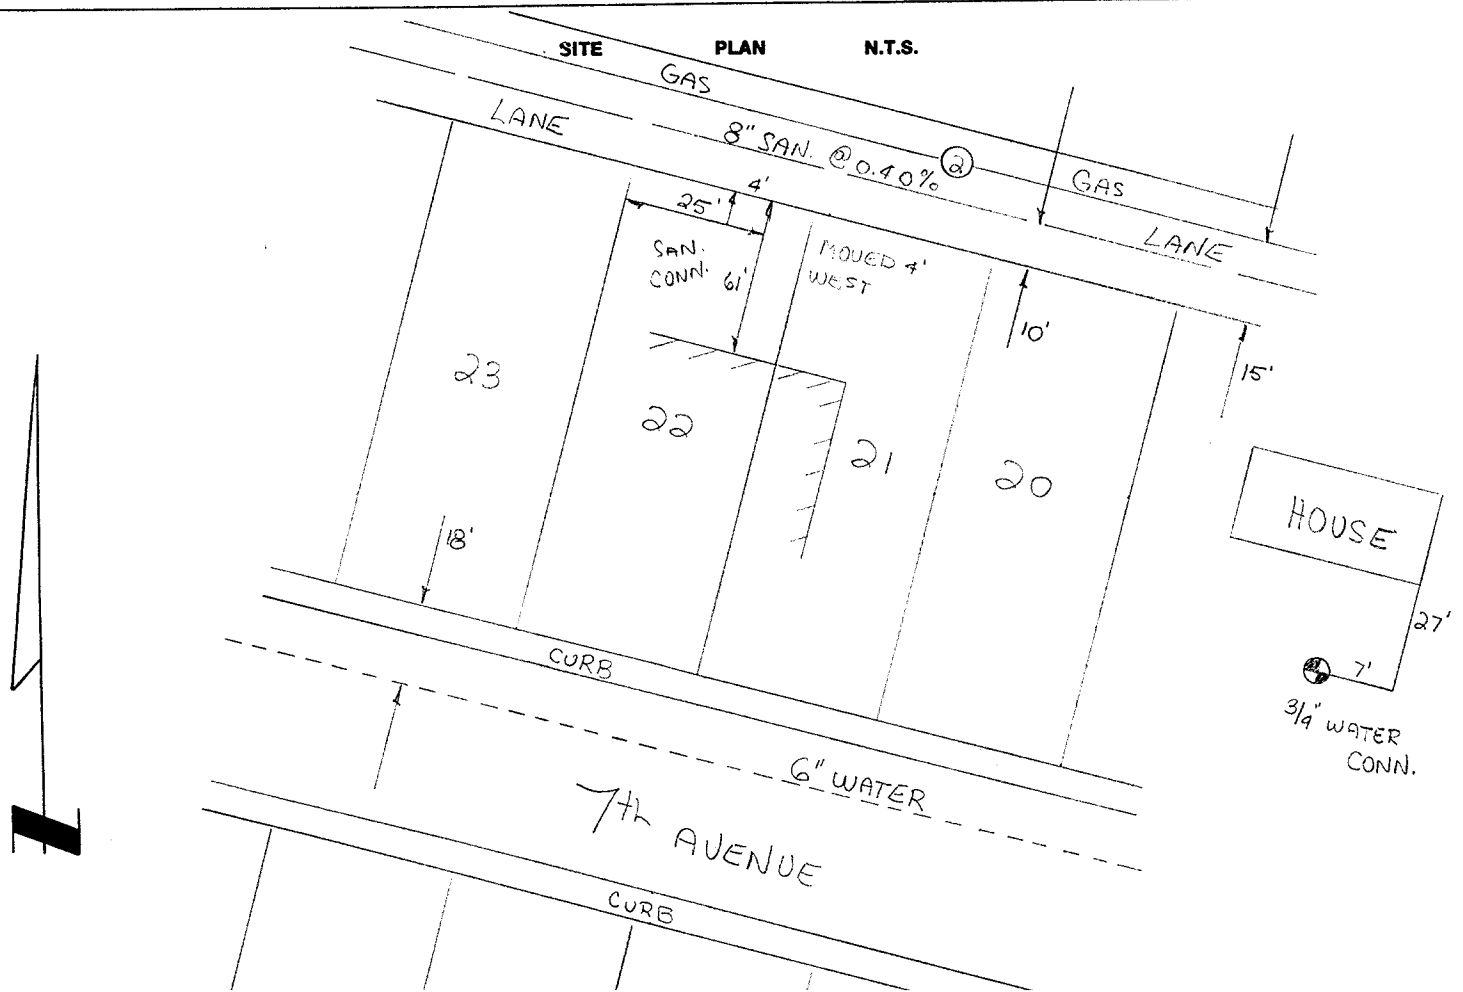
SITE PLAN N.T.S.