City of Prince George
HISTORY SHEET

SHEET NUMBER № 1716 **Roll Number** 004-092-490

Legal: LOT'S 47 BLOCK D.L. 1599 PLAN 14373

Address: 5516 DEER ROAD

Sanitary Connection: # 16198 SIZE 100mm MATERIAL 035 INV. CONNECTED

Water Connection # 12084 SIZE 20mm MATERIAL METER CONNECTED

Storm Connection: # SIZE MATERIAL INV. CONNECTED

Cash Receipt No's: WATER 1339 SANITARY STORM

CURB FROM PROPERTY LINE PAVEMENT WIDTH

B.C. HYDRO UNDERGROUND CONNECTION

B.C. TELEPHONE UNDERGROUND CONNECTION

INLAND GAS Gas shown

Information Sheets:

Comments:
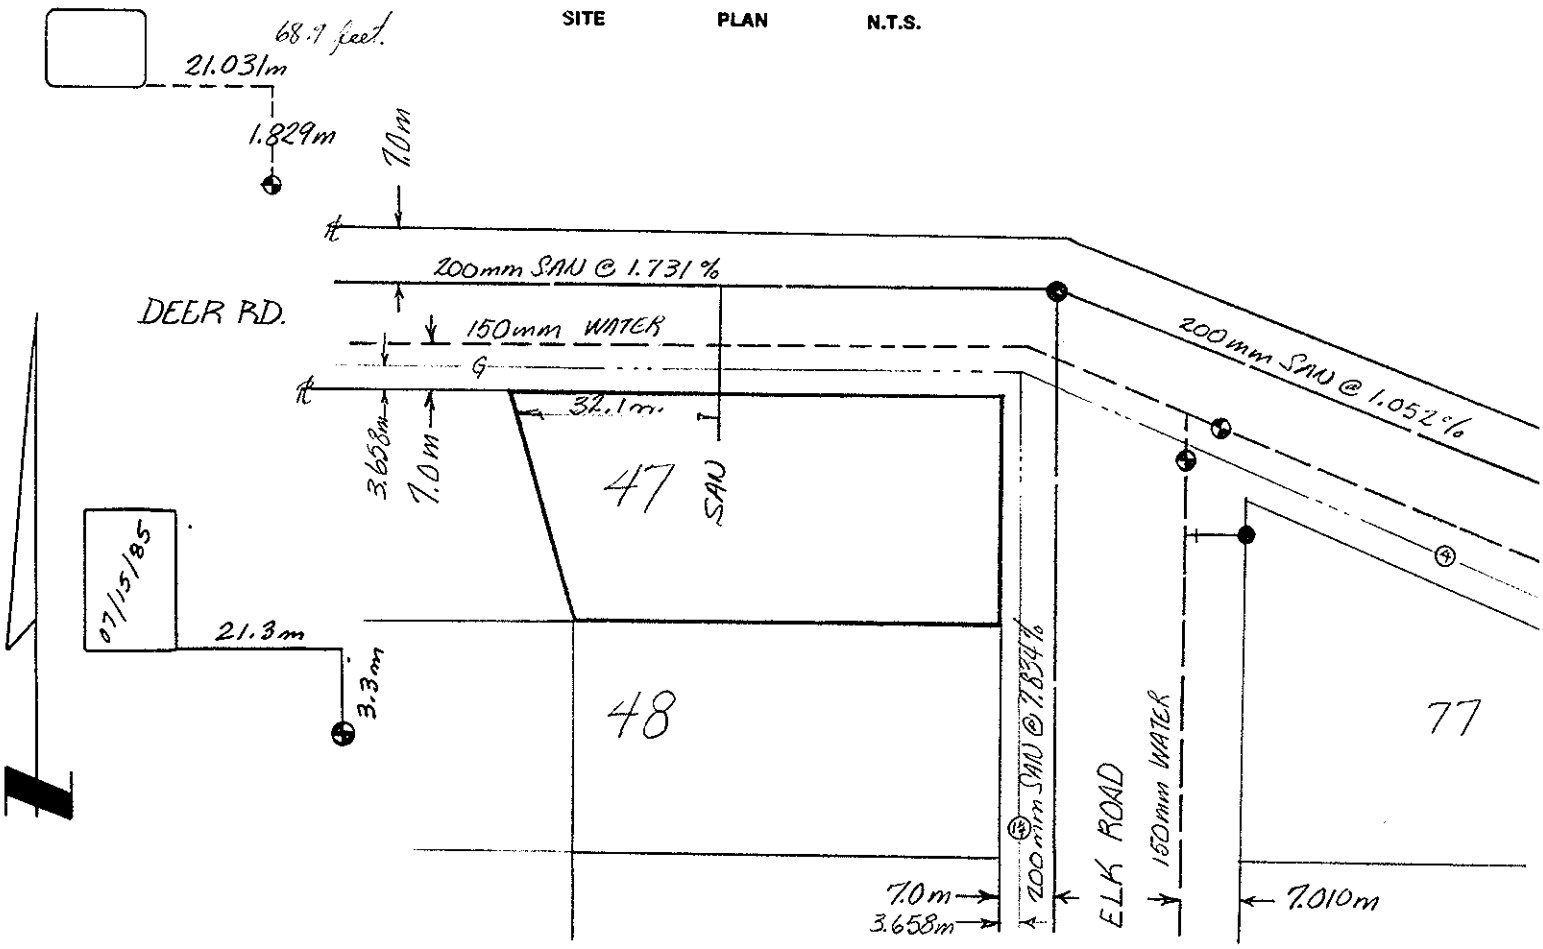
SITE PLAN N.T.S.