City of Prince George
HISTORY SHEET

D 5

SHEET NUMBER № 2460 **Roll Number** 004/165462

Legal: LOT'S 13 BLOCK D.L. 1545 PLAN 13257

Address: 3538 SOUTH BLACKBURN ROAD

Sanitary Connection: # 11042 SIZE 100mm MATERIAL PVC INV. CONNECTED

Water Connection # B.I.D SIZE 19mm MATERIAL Cu METER CONNECTED SEPT 2/70

Storm Connection: # SIZE MATERIAL INV. CONNECTED

Cash Receipt No's: WATER SEPT 26/69 SANITARY STORM

CURB FROM PROPERTY LINE PAVEMENT WIDTH

B.C. HYDRO UNDERGROUND CONNECTION

B.C. TELEPHONE UNDERGROUND CONNECTION

INLAND GAS

Information Sheets:

Comments:
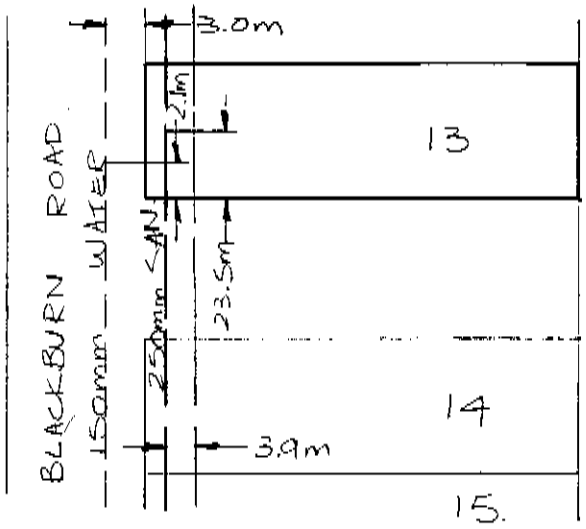
SITE PLAN N.T.S.