City of Prince George
HISTORY SHEET

SHEET NUMBER [redacted] **Roll Number** 004195876

Legal: LOT'S 47 BLOCK D.L. 1599 PLAN 11601

Address: 6912 TONY RD. (A. FITZGERALD)

Sanitary Connection: # 16225 SIZE 100mm MATERIAL INV. CONNECTED

Water Connection # 11972 SIZE 20mm MATERIAL CU. METER CONNECTED

Storm Connection: # SIZE MATERIAL INV. CONNECTED

Cash Receipt No's: WATER 1271 SANITARY STORM

CURB FROM PROPERTY LINE PAVEMENT WIDTH

B.C. HYDRO UNDERGROUND CONNECTION

B.C. TELEPHONE UNDERGROUND CONNECTION

INLAND GAS as shown

Information Sheets:

Comments:
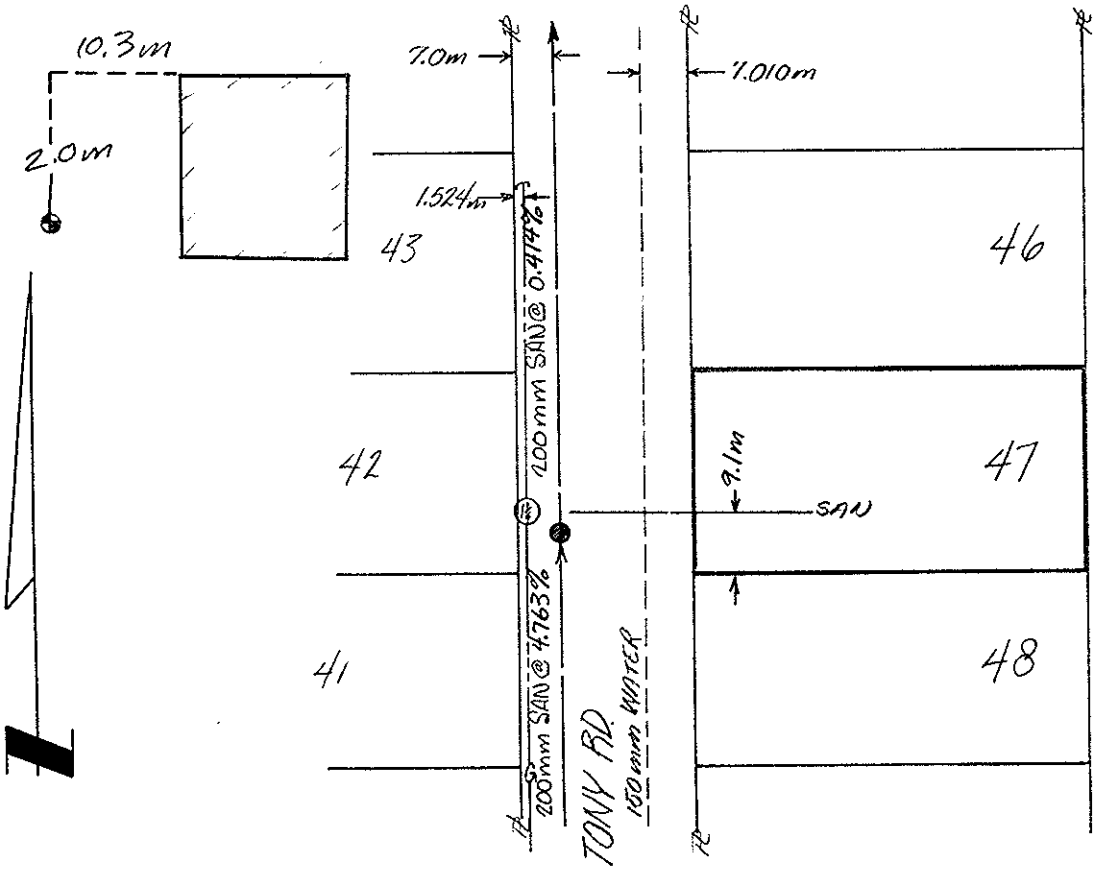
SITE PLAN N.T.S.