City of Prince George
HISTORY SHEET

SHEET NUMBER **Roll Number** 0041223683

Legal: LOT'S 12 BLOCK D.L. 1427 PLAN 16863

Address: 134 McKINLEY CRES.

Sanitary Connection: # 6159 SIZE 100mm MATERIAL INV. 609.097 CONNECTED

Water Connection # 6159 SIZE 20mm MATERIAL CU METER CONNECTED

Storm Connection: # SIZE MATERIAL INV. CONNECTED

Cash Receipt No's: WATER SANITARY STORM

CURB FROM PROPERTY LINE 4.877m PAVEMENT WIDTH 10.363m

B.C. HYDRO AS SHOWN UNDERGROUND CONNECTION

B.C. TELEPHONE AS SHOWN UNDERGROUND CONNECTION

INLAND GAS AS SHOWN

Information Sheets:

Comments:
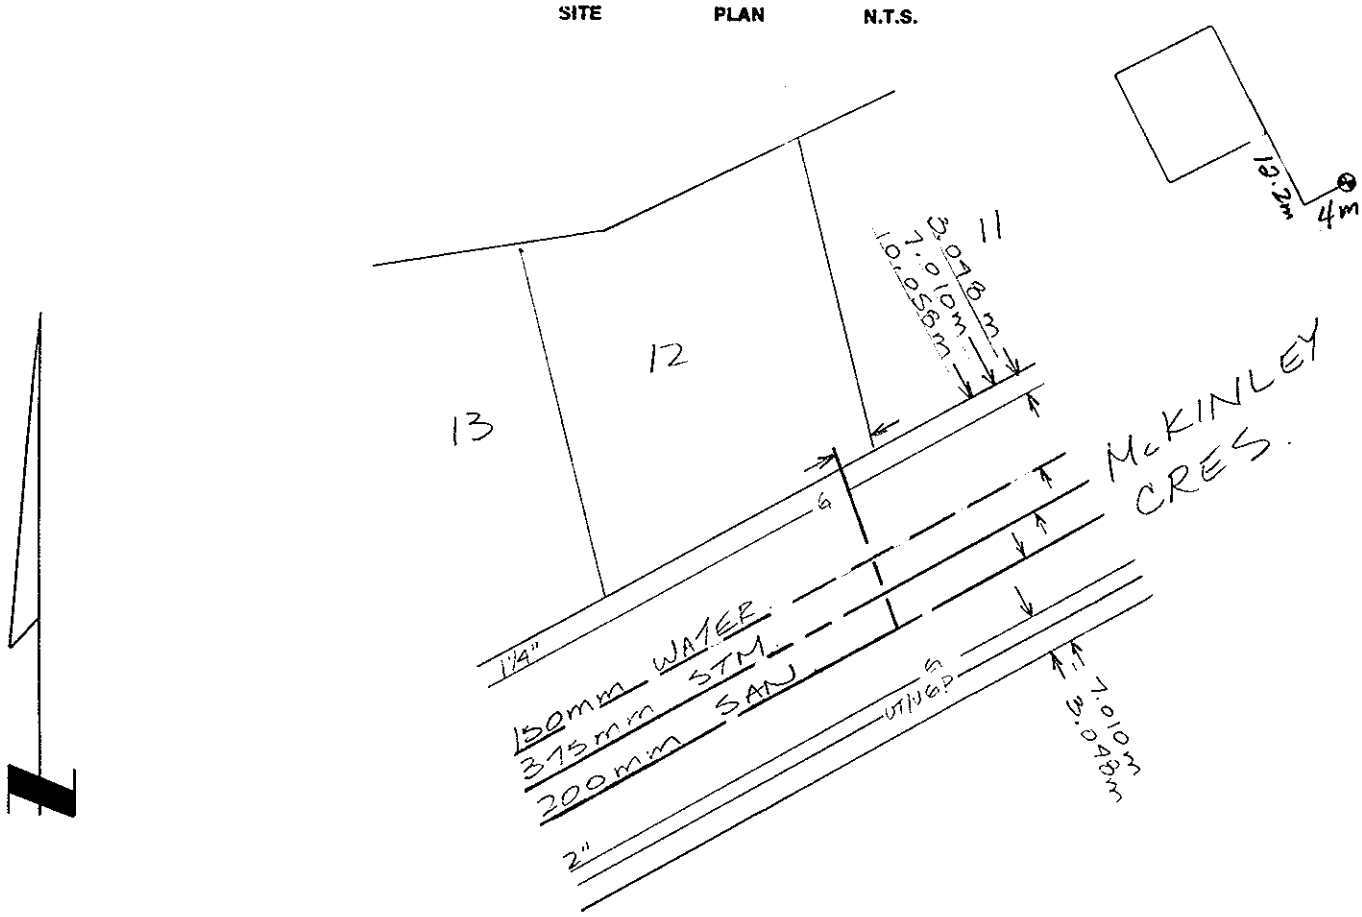
SITE PLAN N.T.S.