City of Prince George
HISTORY SHEET

SHEET NUMBER **Roll Number** 004334332

Legal: LOT'S 144 BLOCK D.L. 937 PLAN 9107

Address: 3027 1st Ave

Sanitary Connection: # 844 SIZE MATERIAL INV. 595.733 CONNECTED

Water Connection # 2144 SIZE 20 mm MATERIAL Cu METER CONNECTED

Storm Connection: # SIZE MATERIAL INV. CONNECTED

Cash Receipt No's: WATER SANITARY STORM

CURB FROM PROPERTY LINE PAVEMENT WIDTH

B.C. HYDRO UNDERGROUND CONNECTION

B.C. TELEPHONE UNDERGROUND CONNECTION

INLAND GAS

Information Sheets:

Comments: Sewer & water connections trenched ℄
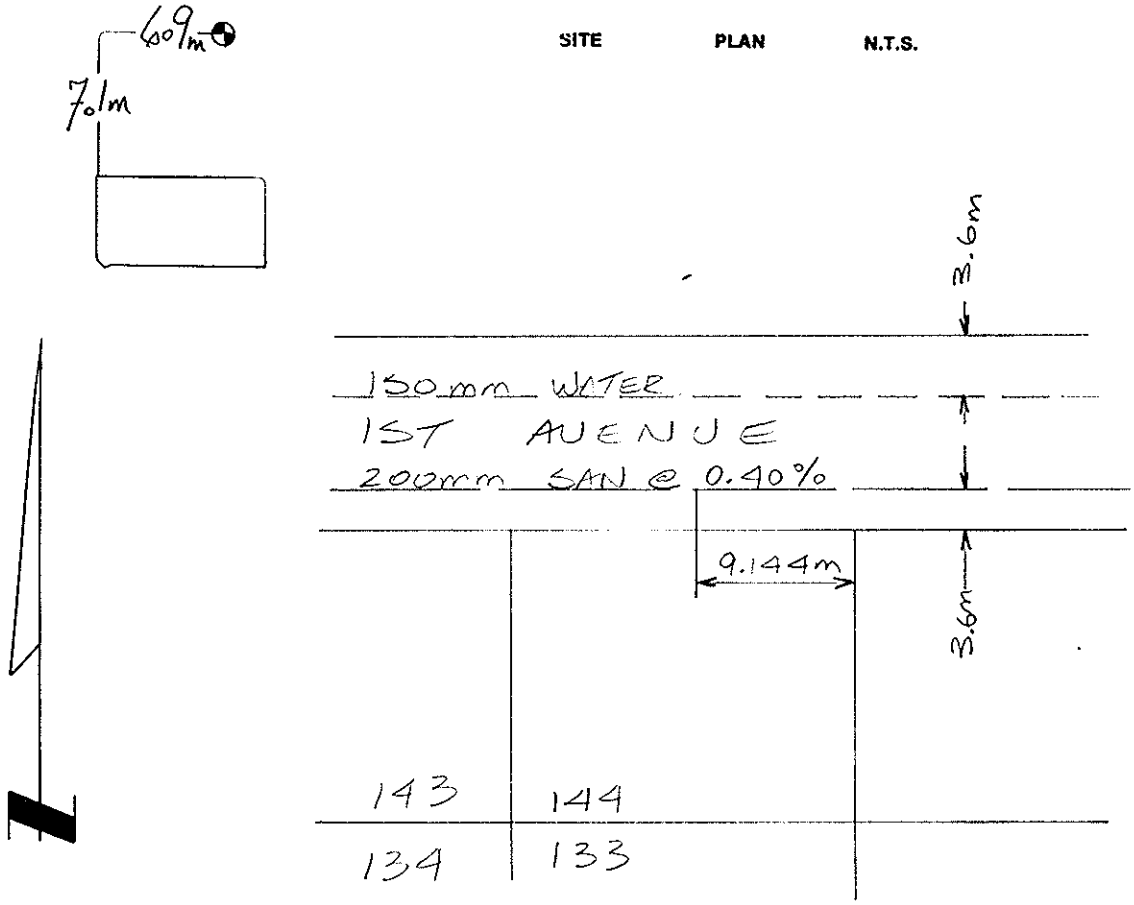
SITE PLAN N.T.S.