City of Prince George
HISTORY SHEET

SHEET NUMBER [redacted] **Roll Number** 004359470

Legal: LOT'S 54 BLOCK D.L. 1599 PLAN 11601

Address: 7116 TONY RD. (E. Groves)

Sanitary Connection: # 16149 SIZE 100mm MATERIAL INV. CONNECTED

Water Connection # 12088 SIZE 20mm MATERIAL Cu METER CONNECTED

Storm Connection: # SIZE MATERIAL INV. CONNECTED

Cash Receipt No's: WATER 1338 SANITARY STORM

CURB FROM PROPERTY LINE PAVEMENT WIDTH

B.C. HYDRO UNDERGROUND CONNECTION

B.C. TELEPHONE UNDERGROUND CONNECTION

INLAND GAS as shown

Information Sheets:
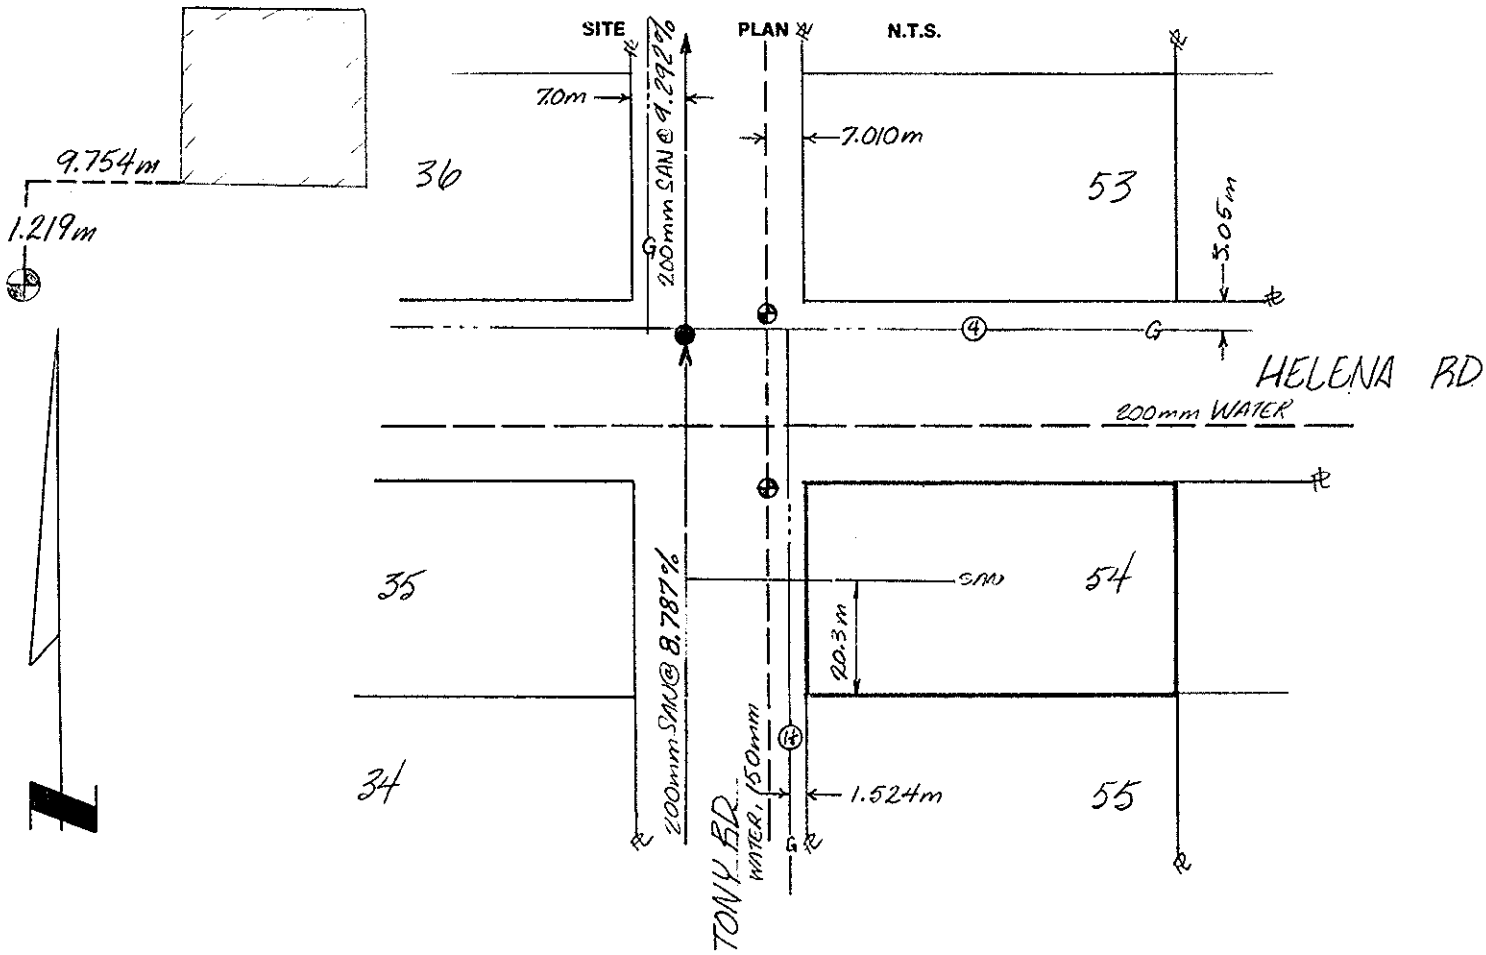
Comments: