950
968
976
984

052

City of Prince George
HISTORY SHEET

SHEET NUMBER № 4957 **Roll Number**

Legal: LOT'S 21 - 33 BLOCK 29 D.L. 627 PLAN 902

Address: 2979 Cessna Rd

Sanitary Connection: # SIZE MATERIAL INV. CONNECTED

Water Connection # SIZE MATERIAL METER CONNECTED

Storm Connection: # SIZE MATERIAL INV. CONNECTED

Cash Receipt No's: WATER SANITARY STORM

CURB FROM PROPERTY LINE PAVEMENT WIDTH

B.C. HYDRO UNDERGROUND CONNECTION

B.C. TELEPHONE UNDERGROUND CONNECTION

INLAND GAS

Information Sheets:
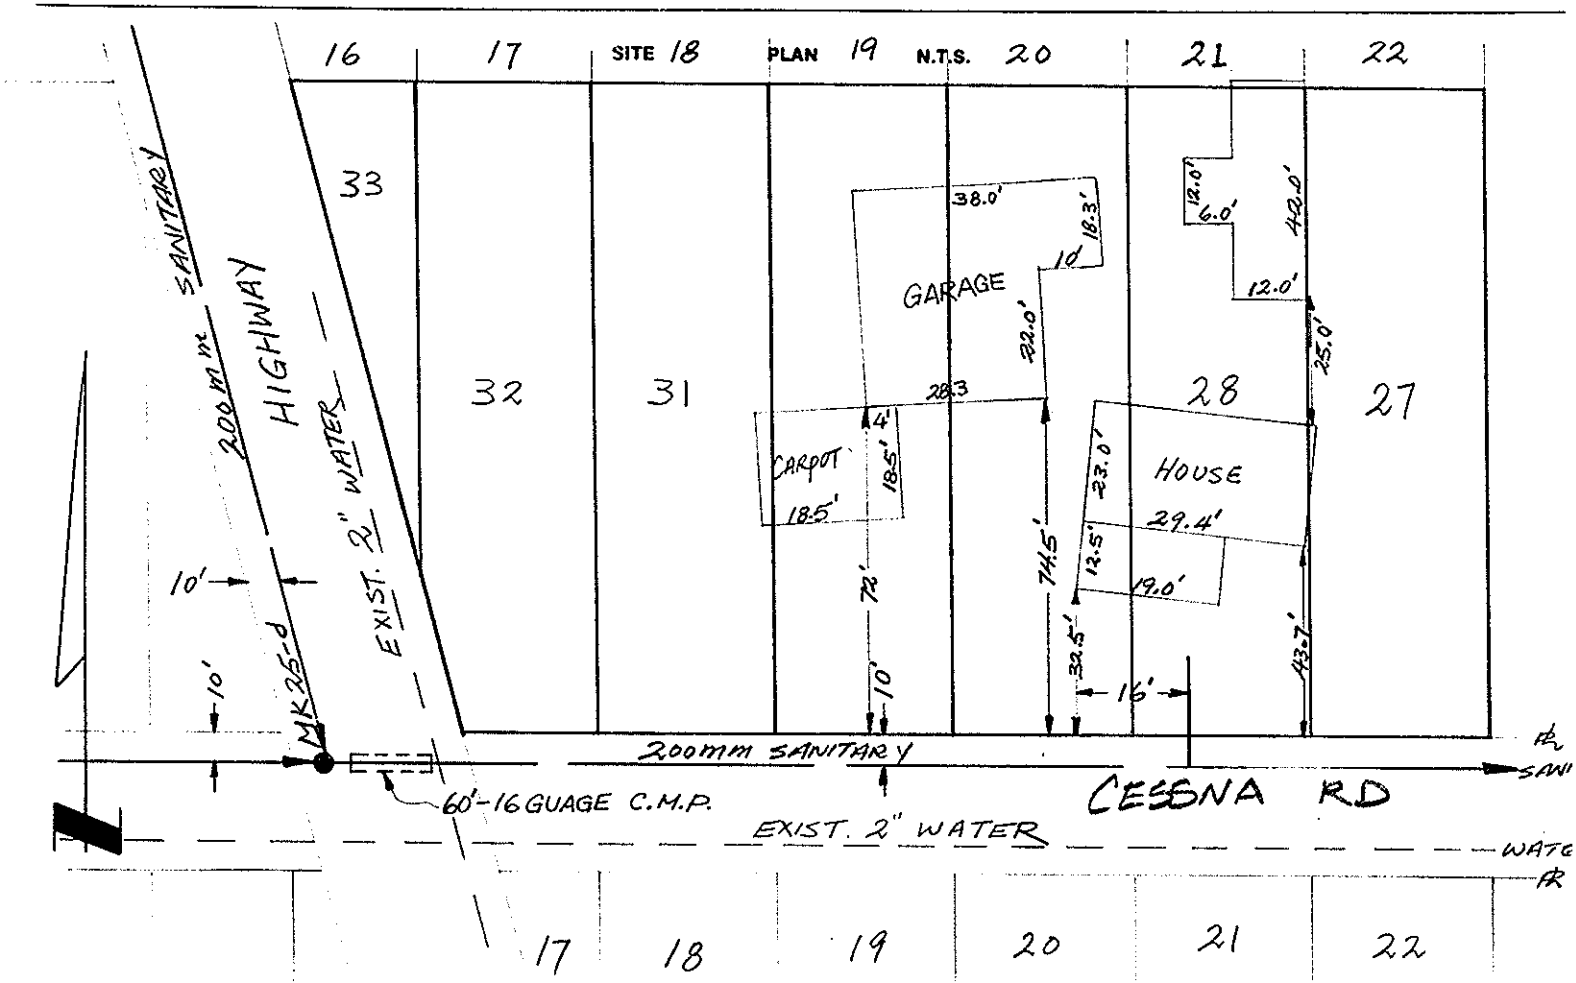
Comments: X/o - 1979 Assess - Joseph Grunwald.