004390377
004390482

City of Prince George
HISTORY SHEET

SHEET NUMBER № 4240 **Roll Number**

Legal: LOT'S 15 - 16 BLOCK 329 D.L. 343 PLAN 1268

Address: 1980 WILLOW ST.

Sanitary Connection: # 6750 SIZE 4" MATERIAL INV. CONNECTED

Water Connection # 715 SIZE 3/4" MATERIAL Cu METER CONNECTED

Storm Connection: # SIZE MATERIAL INV. CONNECTED

Cash Receipt No's: WATER SANITARY STORM

CURB FROM PROPERTY LINE PAVEMENT WIDTH

B.C. HYDRO UNDERGROUND CONNECTION

B.C. TELEPHONE UNDERGROUND CONNECTION

INLAND GAS

Information Sheets:

Comments:
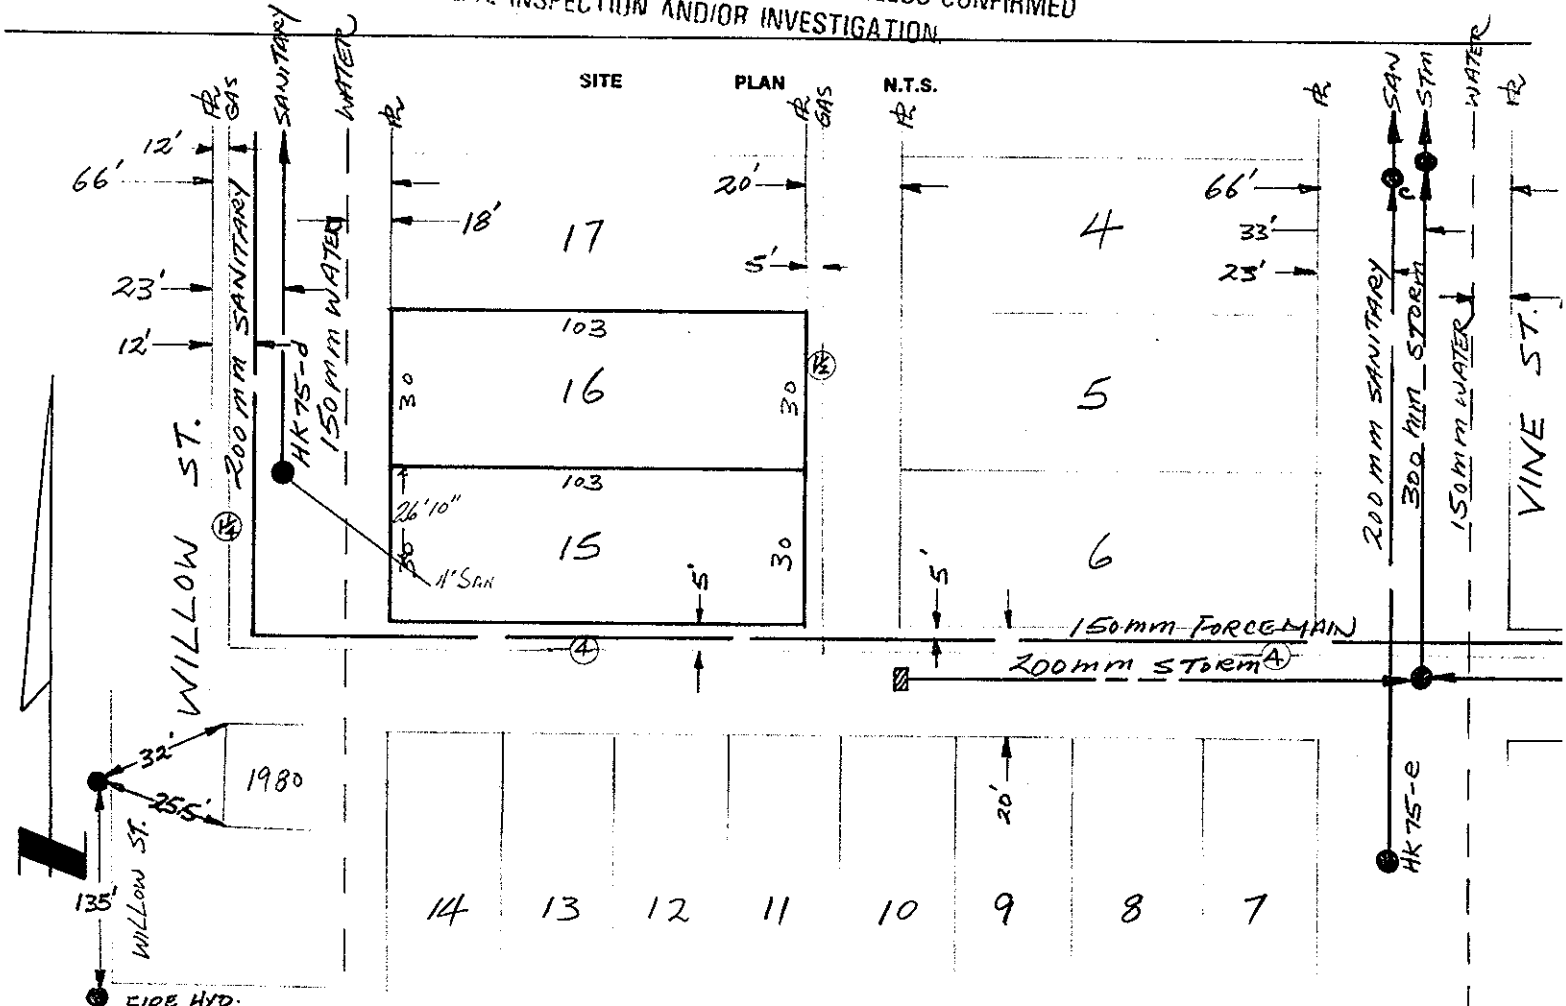
THE INFORMATION CONTAINED HEREIN IS FOR INTERNAL USE ONLY. NOT TO BE RELIED UPON UNLESS CONFIRMED BY SITE INSPECTION AND/OR INVESTIGATION.