City of Prince George
HISTORY SHEET

SHEET NUMBER № 2405 **Roll Number** 004392469

Legal: LOT'S 9 BLOCK D.L. 633 PLAN 15238

Address: WEST BITNER ROAD

Sanitary Connection: # SIZE 4" MATERIAL PVC INV. 98.40 CONNECTED

Water Connection # BID SIZE 3/4" MATERIAL COPPER METER CONNECTED

Storm Connection: # SIZE MATERIAL INV. CONNECTED

Cash Receipt No's: WATER SEPT 2/70 SANITARY AUG 76 STORM

CURB FROM PROPERTY LINE PAVEMENT WIDTH

B.C. HYDRO UNDERGROUND CONNECTION

B.C. TELEPHONE UNDERGROUND CONNECTION

INLAND GAS

Information Sheets:

Comments:
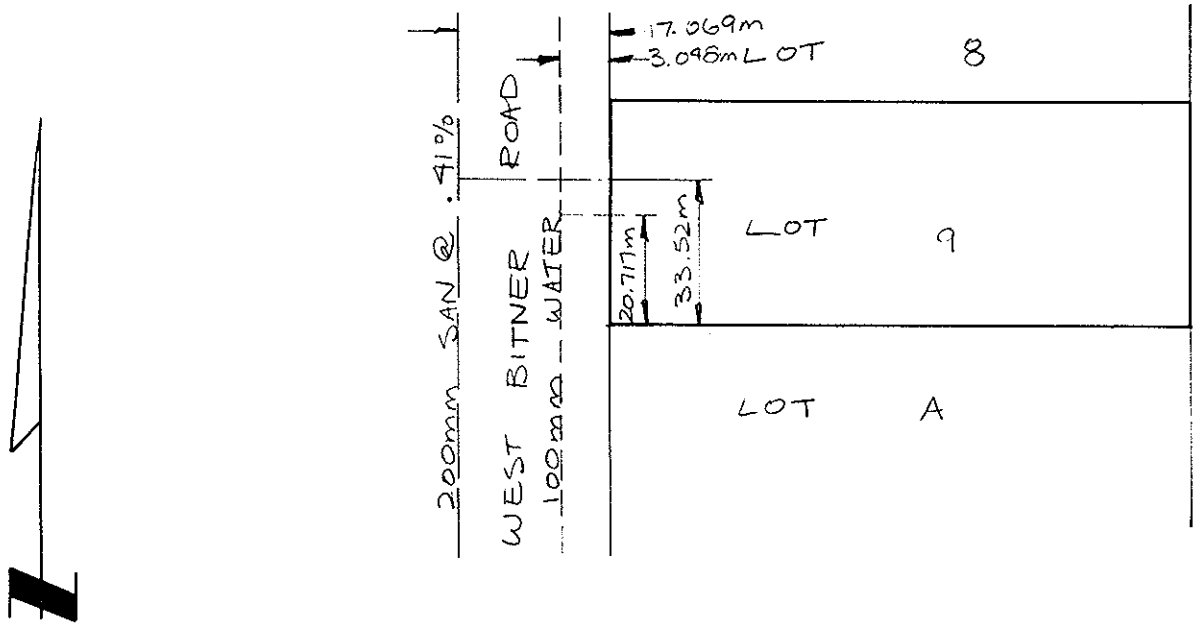
SITE PLAN N.T.S.