City of Prince George
HISTORY SHEET

004393783

SHEET NUMBER № 2740 **Roll Number**

Legal: LOT'S 127 BLOCK D.L. 905 PLAN 24848

Address: 4236 BAKER RD.

Sanitary Connection: # 12826 SIZE 100 mm MATERIAL INV. CONNECTED

Water Connection # 12826 SIZE 19 mm MATERIAL METER CONNECTED

Storm Connection: # 1302 SIZE 100 mm MATERIAL INV. CONNECTED

Cash Receipt No's: WATER SANITARY STORM

CURB FROM PROPERTY LINE PAVEMENT WIDTH

B.C. HYDRO UNDERGROUND CONNECTION

B.C. TELEPHONE UNDERGROUND CONNECTION

INLAND GAS

Information Sheets:

Comments:
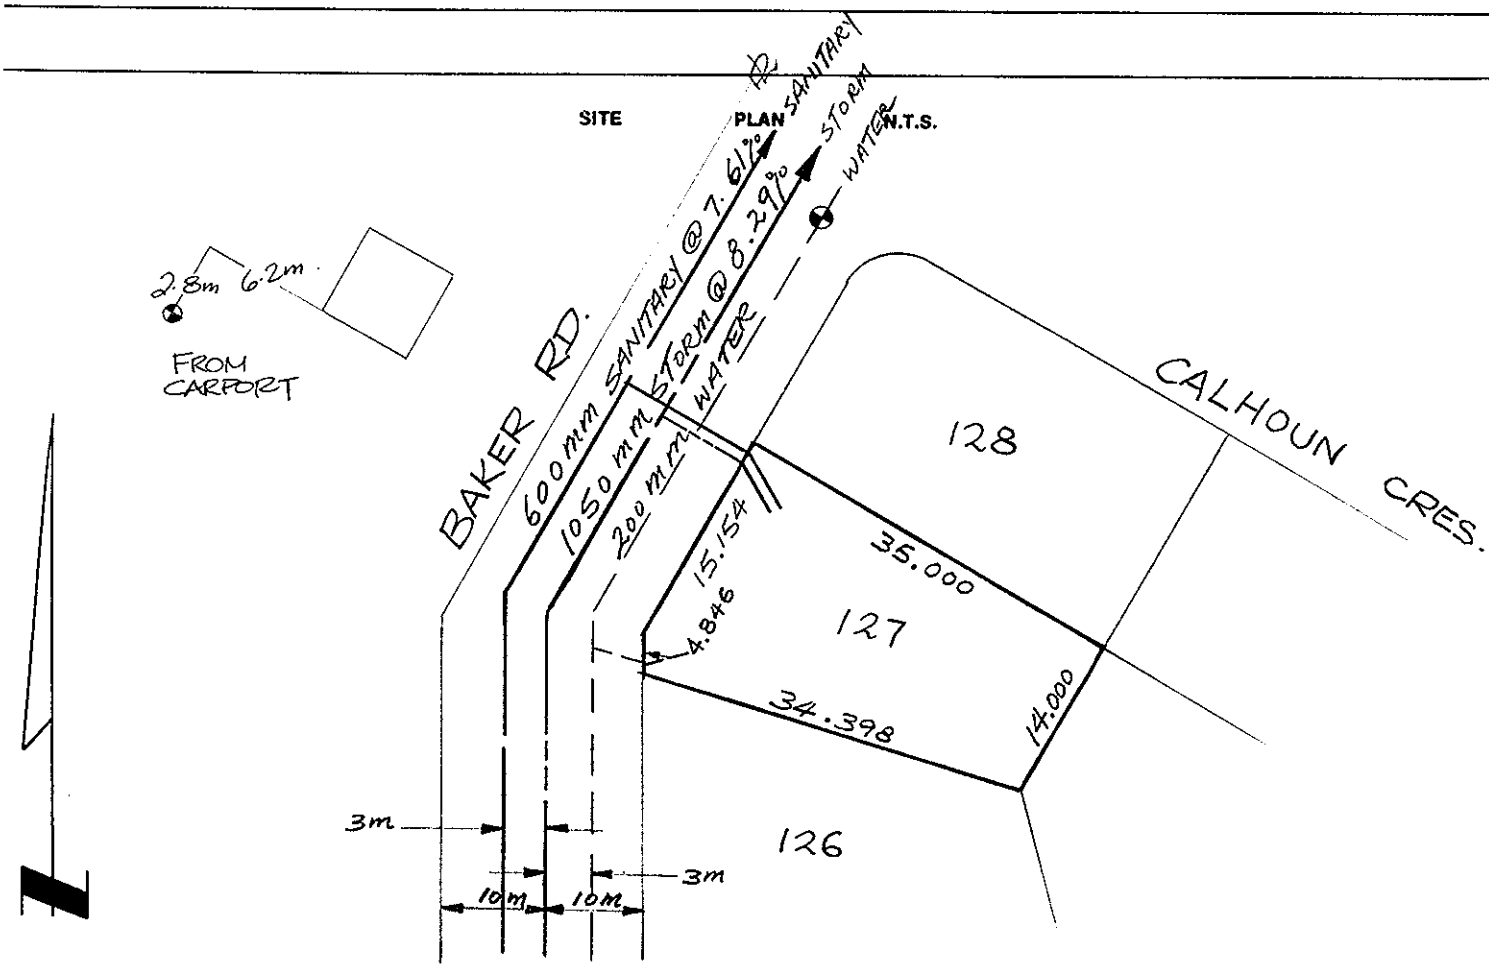
SITE PLAN N.T.S.