Stanley Associates Engineering Ltd.
412, 1488 - 4th Avenue
Prince George, B.C.
V2L 4Y2

HD

City of Prince George
HISTORY SHEET

SHEET NUMBER 3883 Roll Number 001 395 622

Legal: LOT'S 18 BLOCK D.L. 2013 PLAN 025644

Address: 7770 ST. DENIS PL

Sanitary Connection: # SIZE 100ϕ MATERIAL A.C. INV. 651.165 CONNECTED

Water Connection # SIZE 20ϕ MATERIAL Copper METER CONNECTED

Storm Connection: # SIZE 100ϕ MATERIAL A.C. INV. 651.280 CONNECTED

Cash Receipt No's: WATER SANITARY STORM

CURB FROM PROPERTY LINE PAVEMENT WIDTH 10.000

B.C. HYDRO UNDERGROUND CONNECTION U/G

B.C. TELEPHONE UNDERGROUND CONNECTION U/G

INLAND GAS

Information Sheets:

Comments: B.C. HYDRO, INLAND GAS & B.C. TEL. PROPOSED ONLY
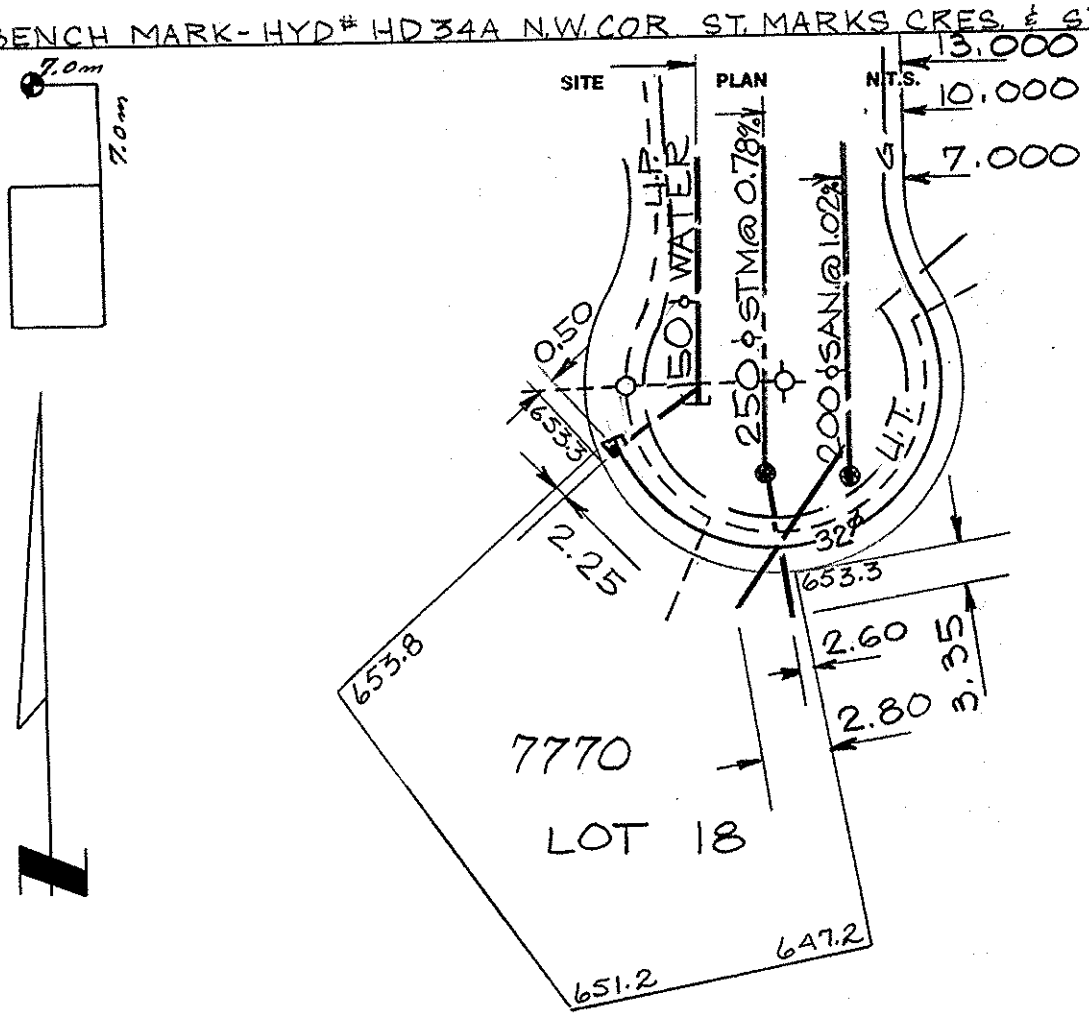
BENCH MARK - HYD# HD34A N.W. COR. ST. MARKS CRES. & ST. MATTHEW PL.