City of Prince George
HISTORY SHEET

SHEET NUMBER **Roll Number** 004408322

Legal: LOT'S NE ¼ of SE ¼ BLOCK D.L. 633 PLAN EXCEPT 9024

Address: 1549 MACKENZIE AVE NORTH R/O Carm.

Sanitary Connection: # 4" SIZE DUC MATERIAL INV. A676 CONNECTED

Water Connection # SIZE 3/4" MATERIAL METER CONNECTED

Storm Connection: # SIZE MATERIAL INV. CONNECTED

Cash Receipt No's: WATER March 12/68 July 20/71 SANITARY STORM

CURB FROM PROPERTY LINE PAVEMENT WIDTH

B.C. HYDRO UNDERGROUND CONNECTION

B.C. TELEPHONE UNDERGROUND CONNECTION

INLAND GAS

Information Sheets:

Comments:
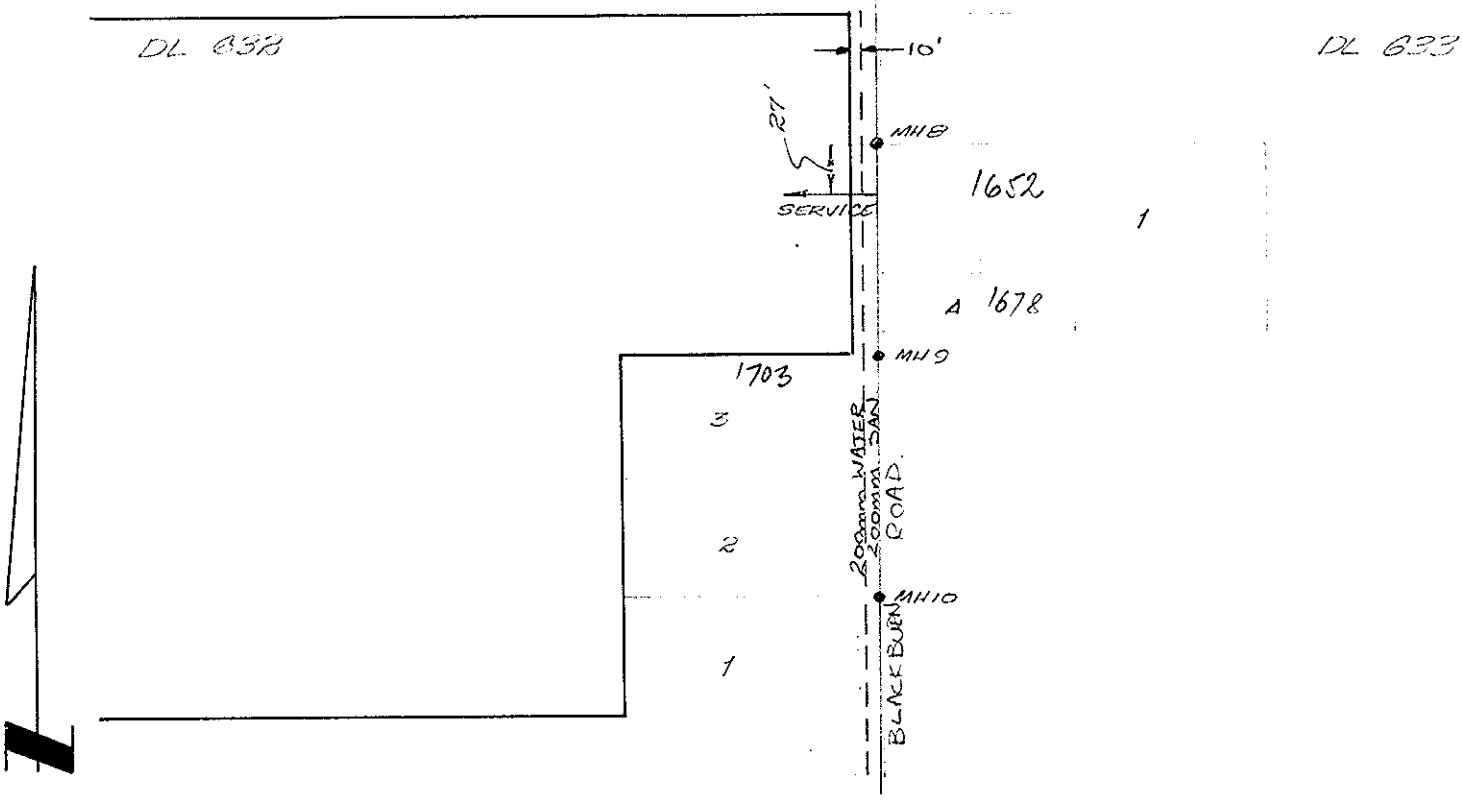
SITE PLAN N.T.S.