City of Prince George
HISTORY SHEET

SHEET NUMBER **Roll Number**

Legal: LOT'S A BLOCK D.L. 2608 PLAN (21699) PG 5248

Address: 111 TABOR BLVD

Sanitary Connection:	# 9537 9538	SIZE	200mm 200mm	MATERIAL	AC AC	INV.	CONNECTED
Water Connection	# 9537 9538	SIZE	150mm 150mm	MATERIAL	AC AC	METER	CONNECTED
Storm Connection:	# 477 483 484	SIZE	250mm 250mm 250mm	MATERIAL	AC VIT VIT	INV.	CONNECTED

Cash Receipt No's: WATER SANITARY STORM 570 621 620

CURB FROM PROPERTY LINE PAVEMENT WIDTH

B.C. HYDRO UNDERGROUND CONNECTION

B.C. TELEPHONE UNDERGROUND CONNECTION

INLAND GAS

Information Sheets:

Comments:
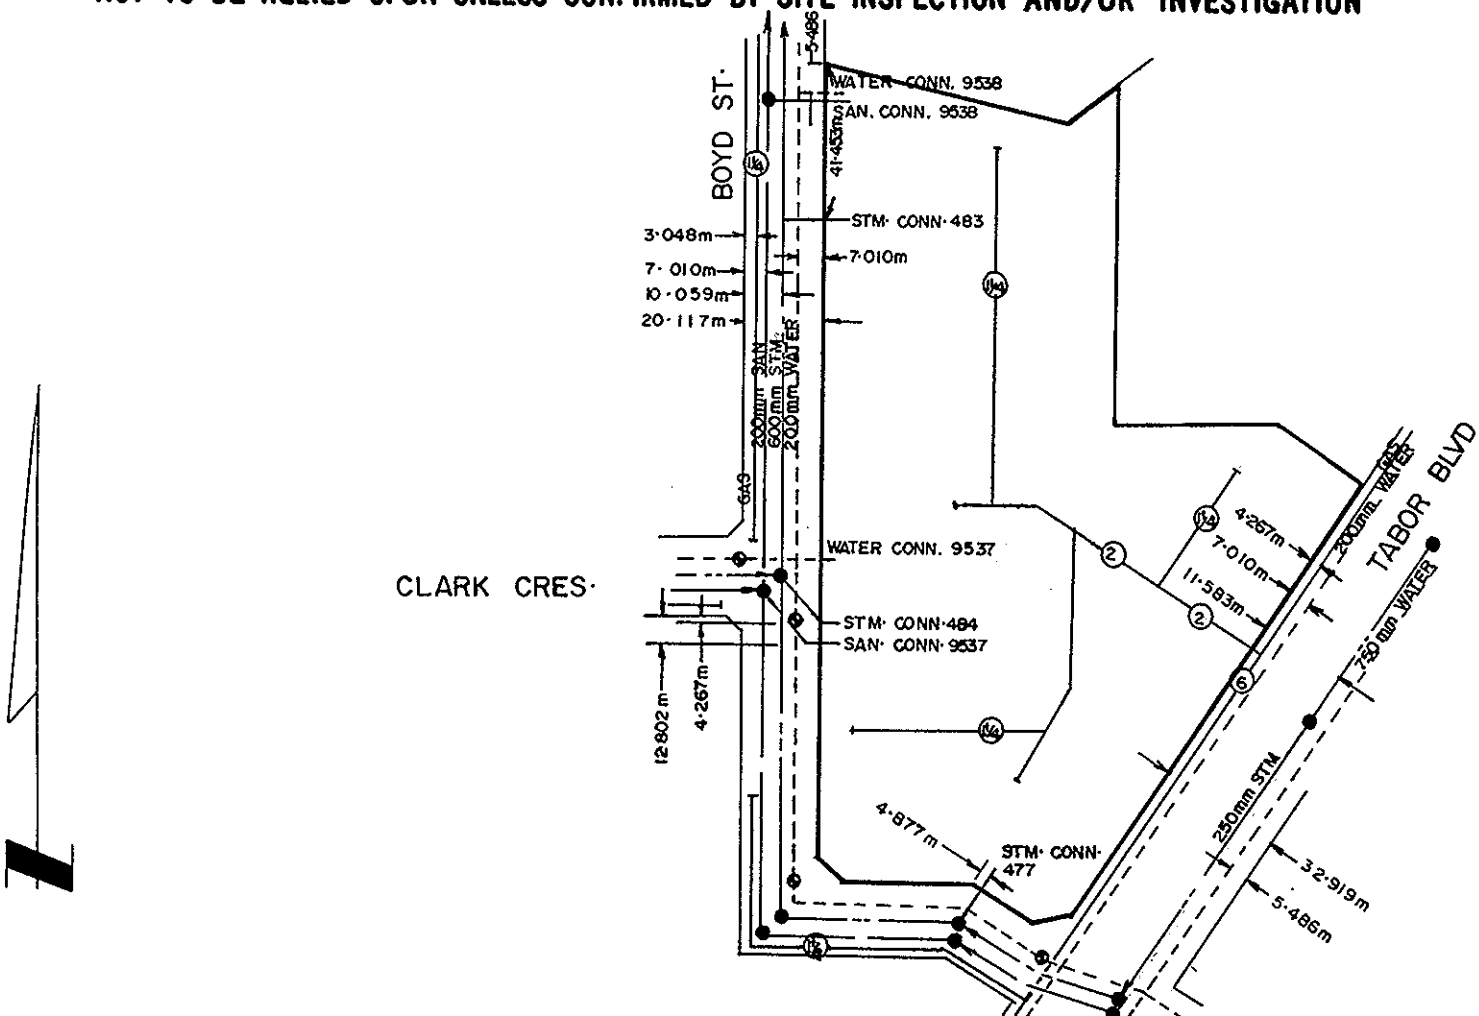
THE INFORMATION CONTAINED HEREIN IS FOR INTERNAL USE ONLY.
NOT TO BE RELIED UPON UNLESS CONFIRMED BY SITE INSPECTION AND/OR INVESTIGATION