DS

City of Prince George
HISTORY SHEET

SHEET NUMBER № 4509 **Roll Number** 004419529

Legal: LOT'S 9 BLOCK D.L. 4047 PLAN 27039

Address: 6524 DRIFTWOOD RD

Sanitary Connection: # SIZE 100ϕ MATERIAL PVC INV. 730.92 CONNECTED

Water Connection # SIZE 20ϕ MATERIAL Copper METER NO CONNECTED

Storm Connection: # SIZE 100ϕ MATERIAL PVC INV. 730.95 CONNECTED

Cash Receipt No's: WATER SANITARY STORM

CURB FROM PROPERTY LINE 5.0m (ROLL CURB) PAVEMENT WIDTH 10.0m

B.C. HYDRO O/S 2.7 FROM PL UNDERGROUND CONNECTION U/G MIDLOT

B.C. TELEPHONE O/S 3.0 FROM PL UNDERGROUND CONNECTION U/G MIDLOT

INLAND GAS

Information Sheets:

Comments: BENCH MARK - HYDRANT SPINDLE EAST SIDE OF ROAD IN FRONT OF LOT #9 733.816
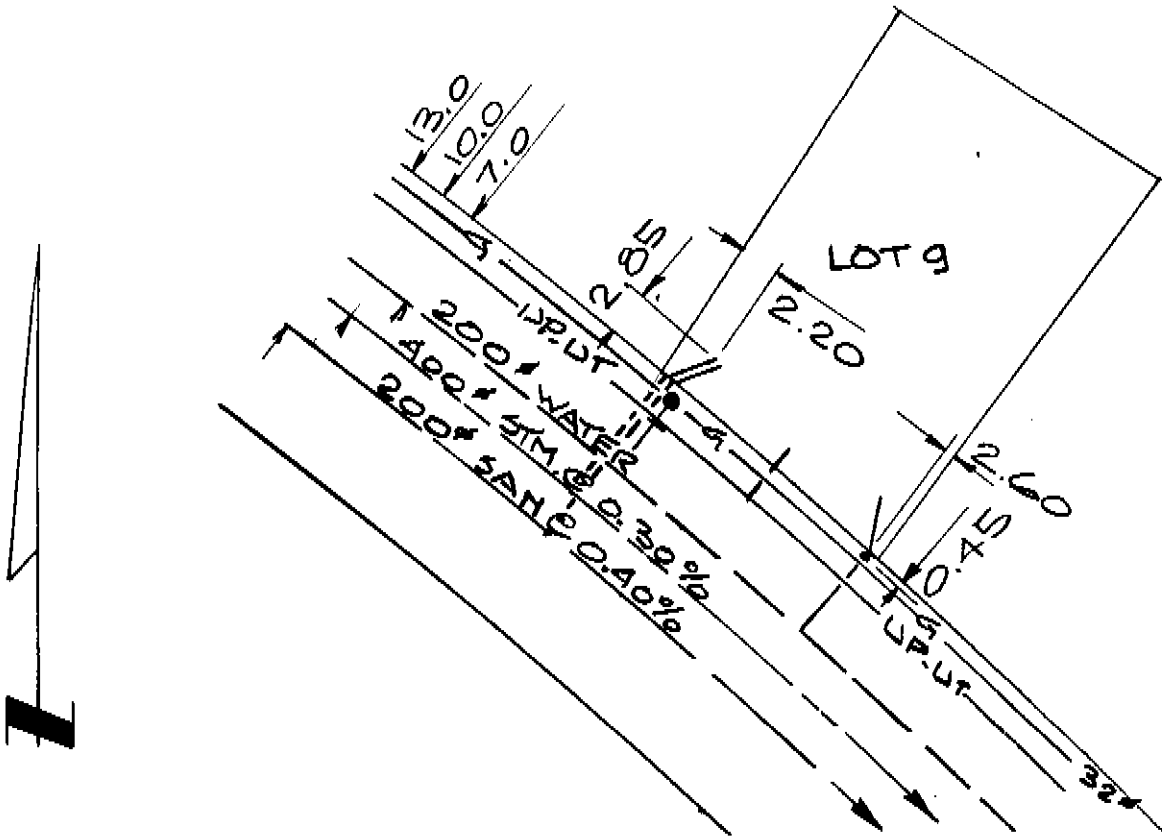
SITE PLAN N.T.S.