City of Prince George
HISTORY SHEET

SHEET NUMBER 8597 | Roll Number

Legal: LOT'S 104 | BLOCK | D.L. 2103 | PLAN 23118

Address: 8100 PRINCETON CRES

Sanitary Connection: # | SIZE 4" | MATERIAL WT PVC | INV. | CONNECTED

Water Connection # | SIZE 3/4" | MATERIAL COPPER | METER | CONNECTED

Storm Connection: # | SIZE 4" | MATERIAL GR PVC | INV. | CONNECTED

Cash Receipt No's: WATER | SANITARY | STORM

CURB FROM PROPERTY LINE 16' | PAVEMENT WIDTH 39'

B.C. HYDRO 3' | UNDERGROUND CONNECTION ✓

B.C. TELEPHONE 3' | UNDERGROUND CONNECTION ✓

INLAND GAS 10'

Information Sheets:
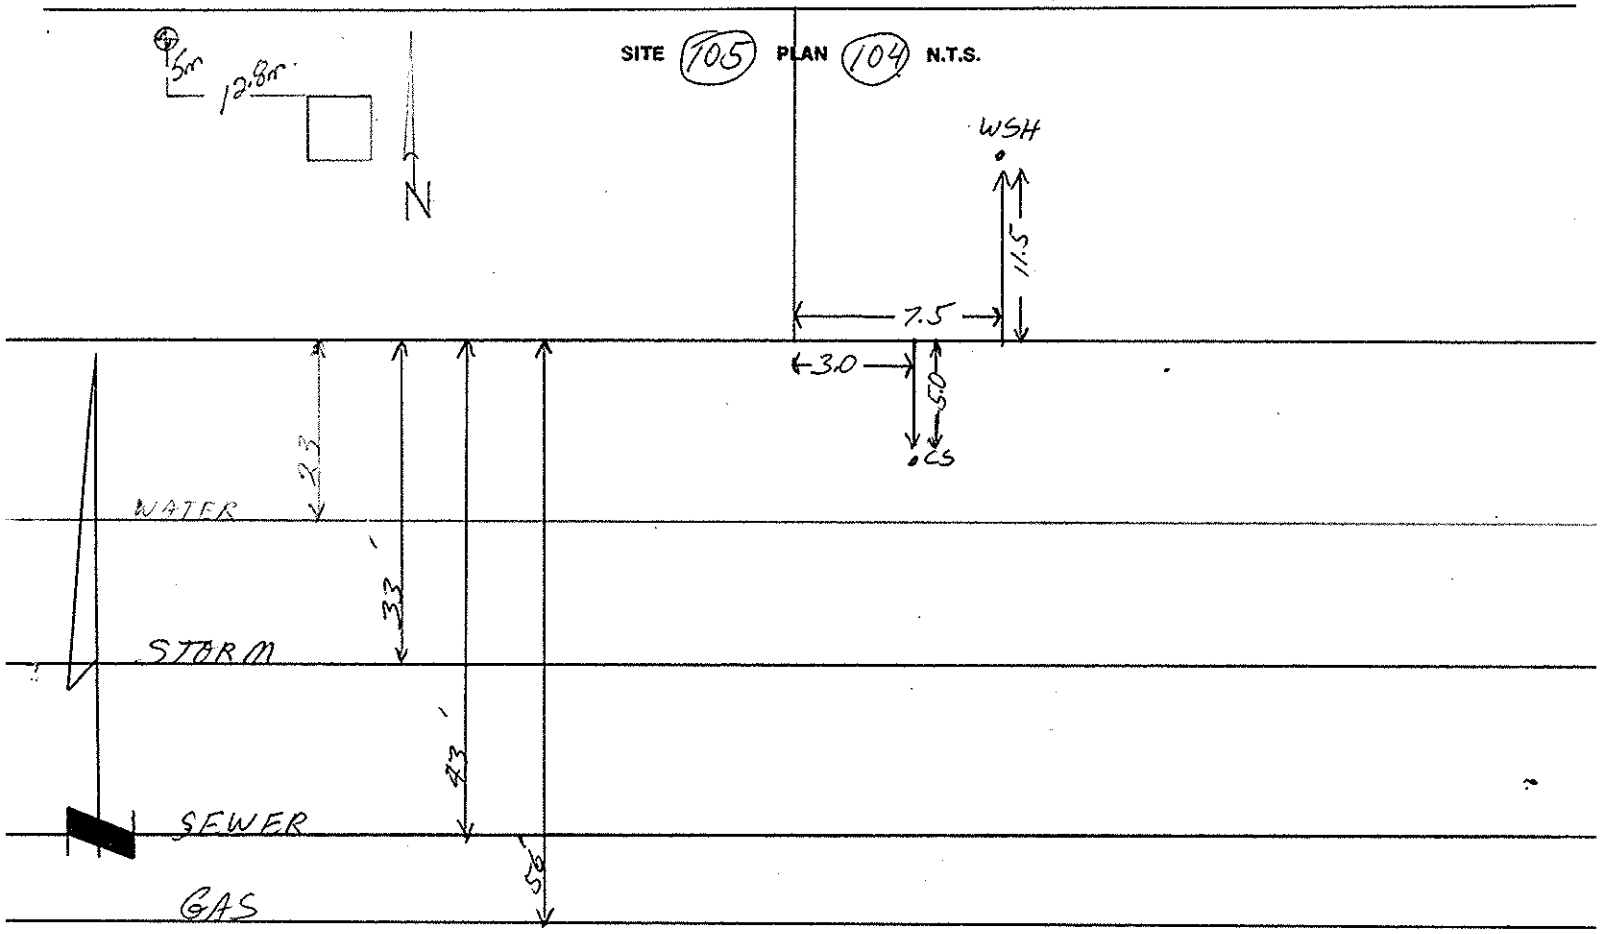
Comments: 66' R/W