City of Prince George
HISTORY SHEET

SHEET NUMBER **7229** **Roll Number** 00417966

Legal: LOT'S 16 BLOCK D.L. 2424 PLAN 15996

Address: 8632 CARONCCDCCCCCCC PETER STREET

Sanitary Connection: # 16626 SIZE 100mm MATERIAL PVC INV. CONNECTED

Water Connection # 16626 SIZE 3/4" MATERIAL Copper METER CONNECTED

Storm Connection: # SIZE MATERIAL INV. CONNECTED

Cash Receipt No's: WATER SANITARY STORM

CURB FROM PROPERTY LINE PAVEMENT WIDTH

B.C. HYDRO UNDERGROUND CONNECTION

B.C. TELEPHONE UNDERGROUND CONNECTION

INLAND GAS

Information Sheets:

Comments: WATER SERVICE: 3' SOUTH OF NW CORNER OF PROP.

OWNER: CARON David Patrick

THE INFORMATION CONTAINED HEREIN IS FOR INTERNAL USE ONLY. NOT TO BE RELIED UPON UNLESS CONFIRMED BY SITE INSPECTION AND/OR INVESTIGATION.
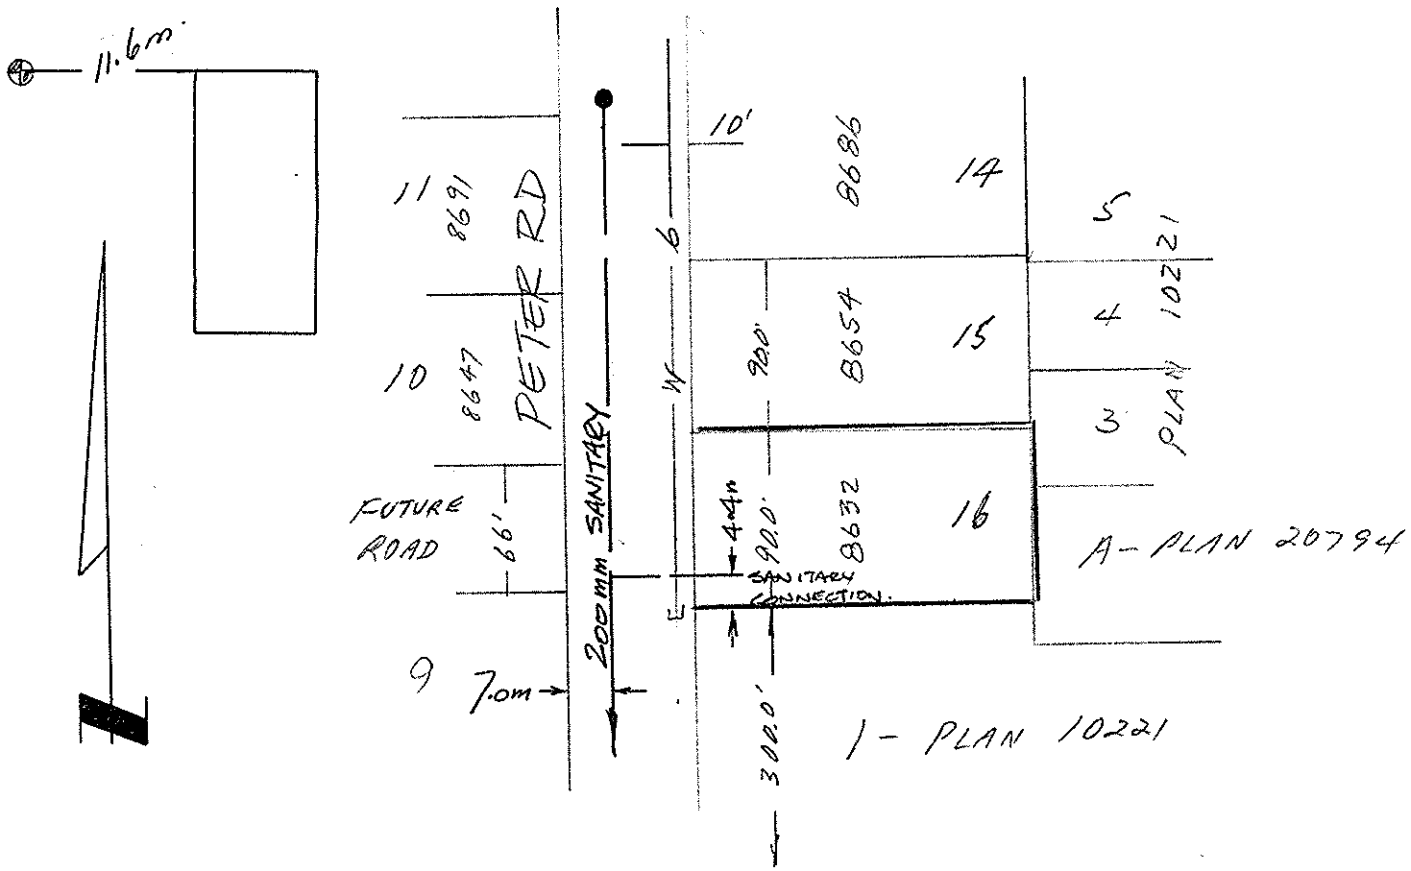
SITE PLAN