Lot Servicing

1764 7TH AVE PID: 004431928

Lot: 18, **Block:** 176, **Plan:** 1268, **DL:** 343

SERVICE	SIZE	MATERIAL	INSTALLED DATE	LOCATION	DETAILS
WATER	20MM	CU		NO LOCATION	CONNECTION NUMBER 11247
SANITARY	100MM	UNKNOWN		5'6" E OF W PL	CONNECTION # 87

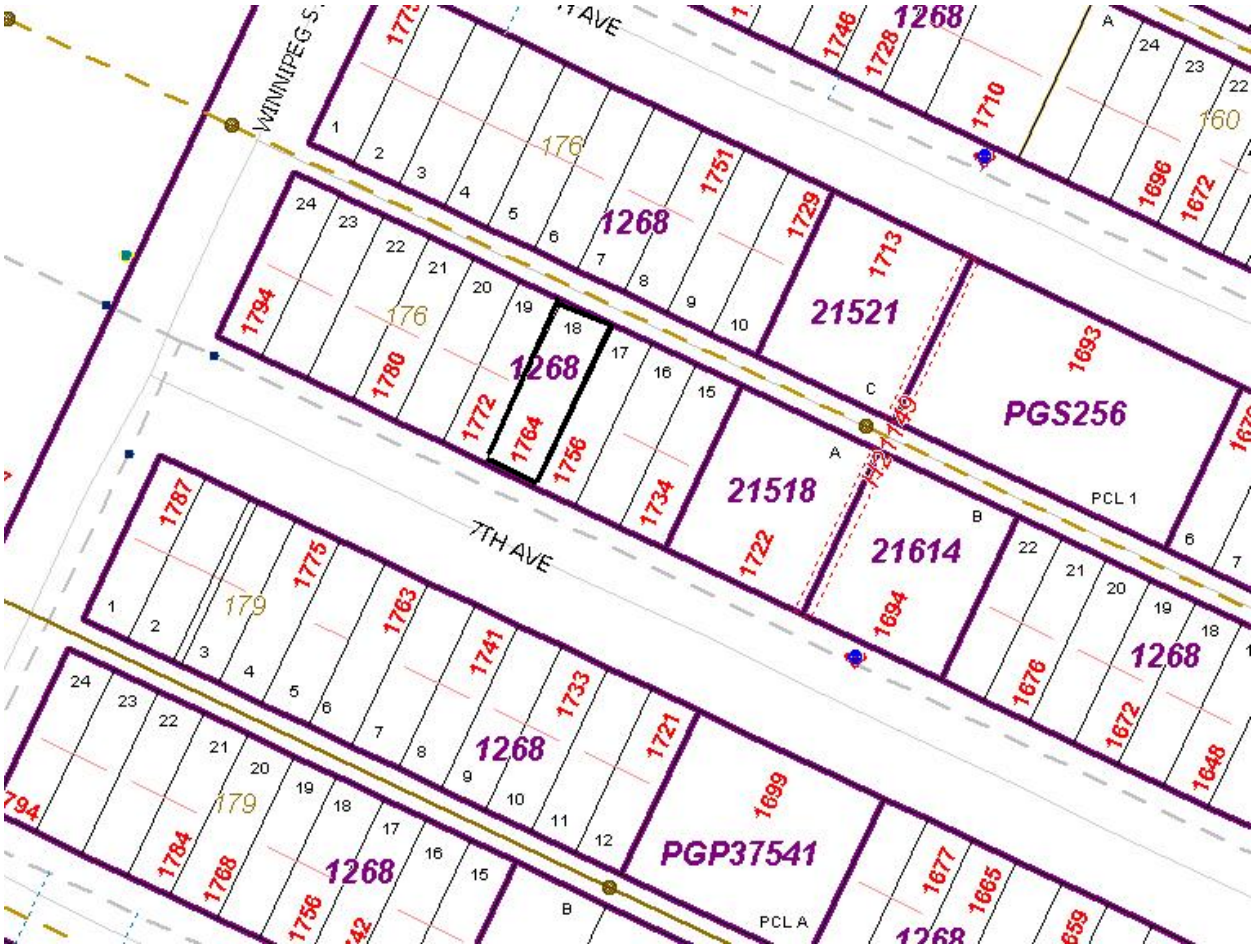

Accuracy not guaranteed unless confirmed by site inspection and/or investigation.
Connection location between main and property line only.