City of Prince George
HISTORY SHEET

SHEET NUMBER **Roll Number** PGS105

Legal: LOT'S Pcl 1 (28265) BLOCK D.L. 4047 PLAN ~~9543~~

Address: 3858 AUSTIN ROAD WEST

Sanitary Connection: # 15225 12143 12147 SIZE 150mm 100mm 100mm MATERIAL INV. CONN. 12143 - 759.120 CONN. 12147 - 757.418 CONNECTED

Water Connection # 15225 12404 11150 EXISTING SIZE 50mm 20mm 3/4" MATERIAL COPPER METER CONNECTED

Storm Connection: # 1412 SIZE 150mm MATERIAL INV. CONNECTED

Cash Receipt No's: WATER 12404 2158 15225 373 SANITARY 12147 2274 15225 372 12143 2273 STORM 374

CURB FROM PROPERTY LINE PAVEMENT WIDTH

B.C. HYDRO O.H. UNDERGROUND CONNECTION

B.C. TELEPHONE O.H. UNDERGROUND CONNECTION

INLAND GAS AS SHOWN

Information Sheets: 579 NIL, 579 15'W

Comments: OLD LOT 47 NID. WATER SERVICE - 8' EAST OF POWER POLE - IN SMALL BOX

THE INFORMATION CONTAINED HEREIN IS FOR INTERNAL USE ONLY. NOT TO BE RELIED UPON UNLESS CONFIRMED BY SITE INSPECTION AND/OR INVESTIGATION.
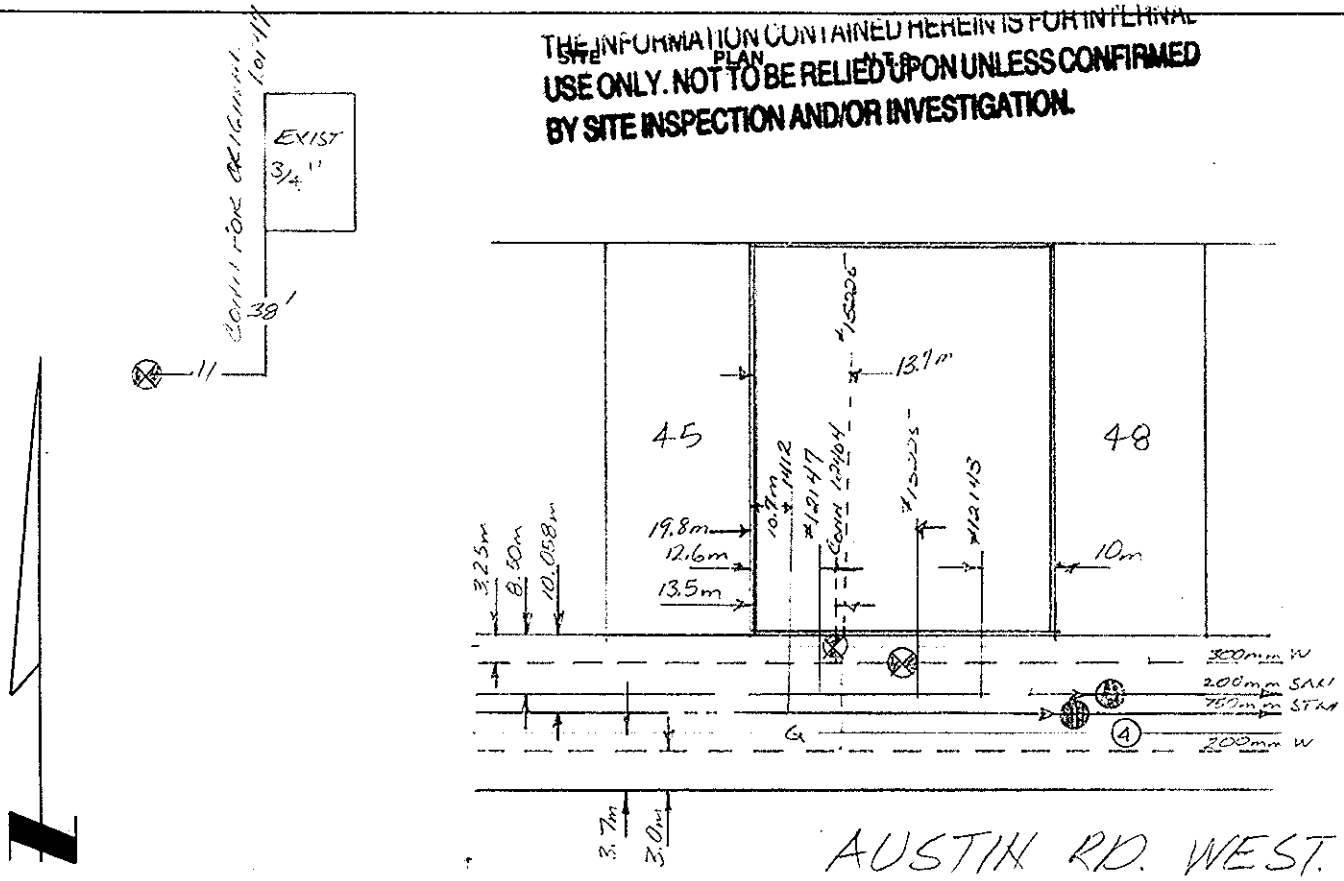
SITE PLAN N.T.S.