City of Prince George
HISTORY SHEET

SHEET NUMBER № 4108 **Roll Number** PGS107

Legal: LOT'S REM. LOT 2 BLOCK D.L. 8178 PLAN (25241)

Address: FERRY AVE. 3155 WESTWOOD DR.

Sanitary Connection: # 15096 SIZE 150mm MATERIAL P/C. INV. CONNECTED

Water Connection # 15096 SIZE 50mm MATERIAL G. METER CONNECTED

Storm Connection: # 1397 SIZE 250mm MATERIAL P/C INV. CONNECTED

Cash Receipt No's: WATER 298 SANITARY 297 STORM 299

CURB FROM PROPERTY LINE PAVEMENT WIDTH

B.C. HYDRO UNDERGROUND CONNECTION

B.C. TELEPHONE UNDERGROUND CONNECTION

INLAND GAS

Information Sheets:
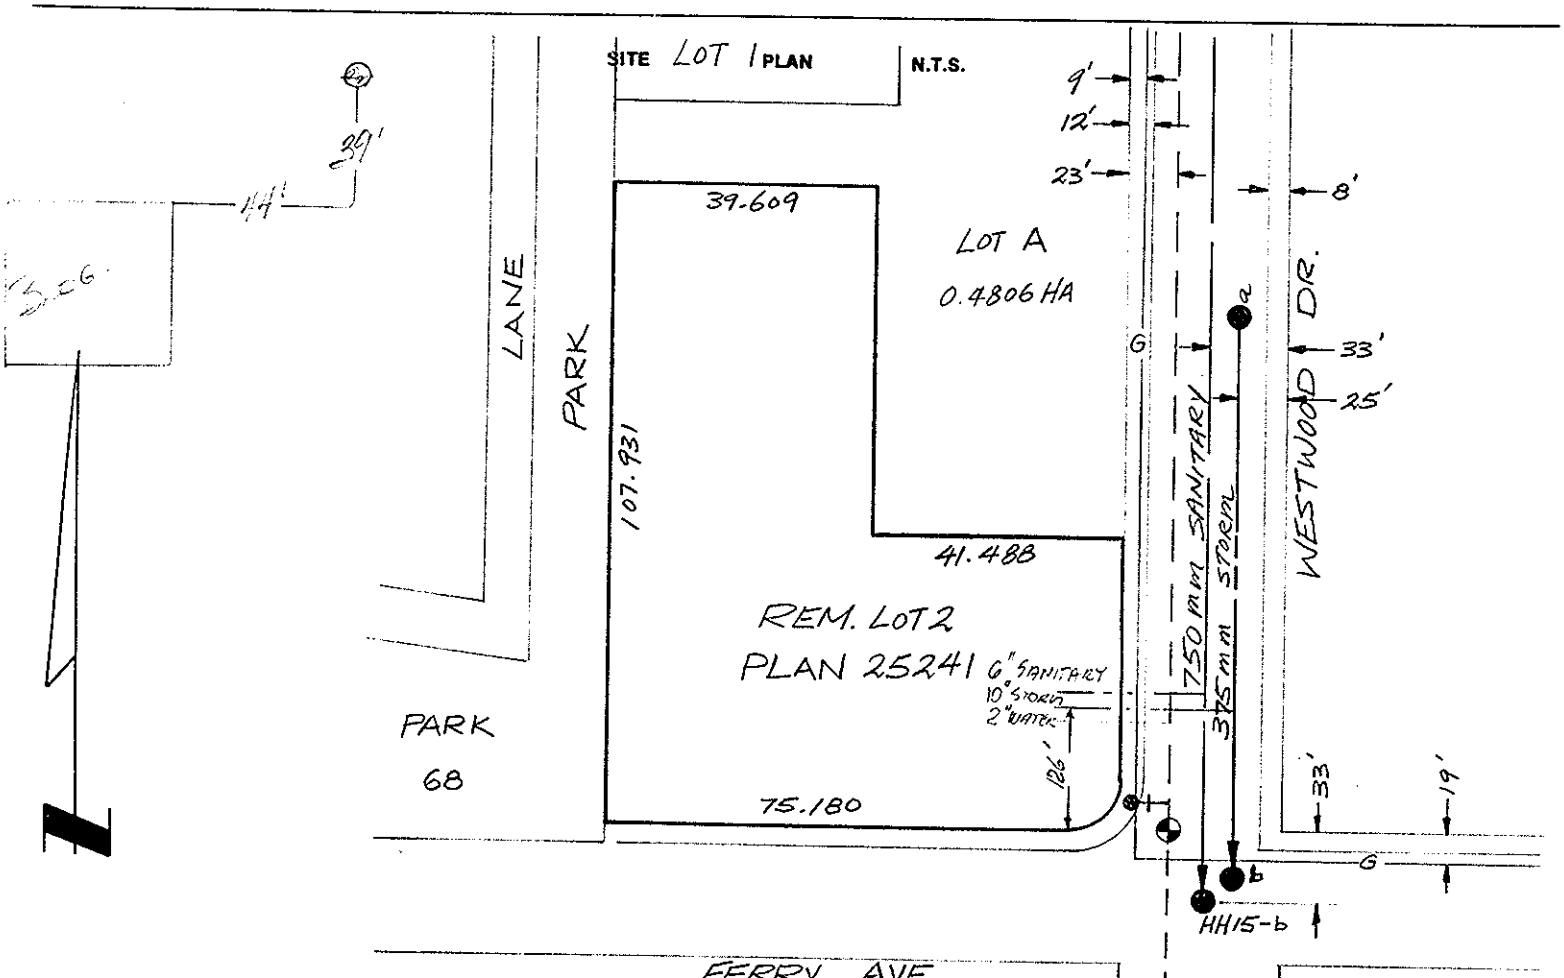
Comments: THE INFORMATION CONTAINED HEREIN IS FOR INTERNAL USE ONLY. NOT TO BE RELIED UPON UNLESS CONFIRMED BY SITE INSPECTION AND/OR INVESTIGATION.