City of Prince George
HISTORY SHEET

SHEET NUMBER № 0682 **Roll Number** 004493401

Legal: LOT'S 52 BLOCK D.L. 2610 PLAN 21450

Address: 304 EXPLORER CRES.

Sanitary Connection: # 9051 SIZE 100mm MATERIAL A.C. INV. CONNECTED

Water Connection # SIZE 20mm MATERIAL Cu METER CONNECTED

Storm Connection: # SIZE MATERIAL INV. CONNECTED

Cash Receipt No's: WATER SANITARY STORM

CURB FROM PROPERTY LINE 4.877m PAVEMENT WIDTH 10.363m

B.C. HYDRO UNDERGROUND UNDERGROUND CONNECTION YES

B.C. TELEPHONE UNDERGROUND UNDERGROUND CONNECTION YES

INLAND GAS As Shown

Information Sheets:

Comments:

10m
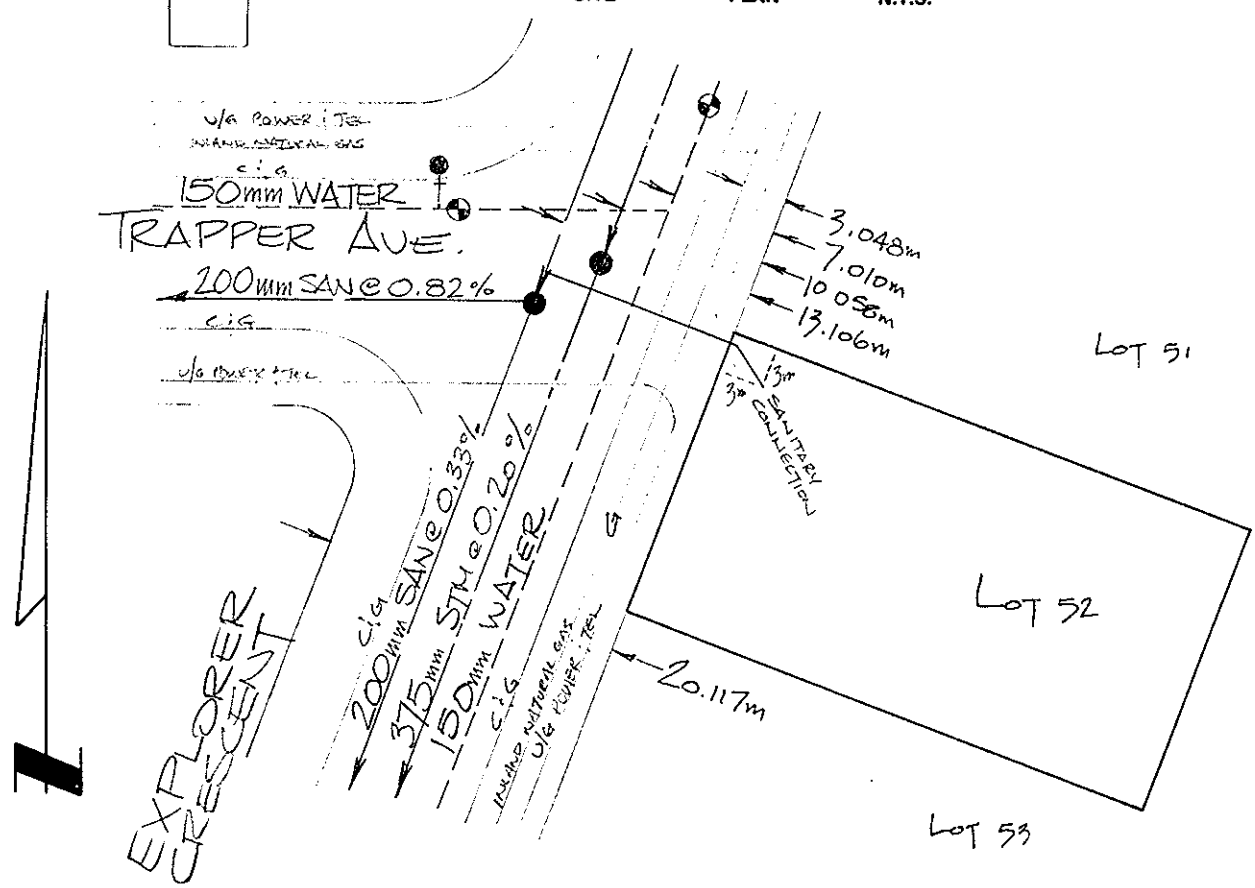
SITE PLAN N.T.S.