City of Prince George
HISTORY SHEET

004580206

SHEET NUMBER

Roll Number 25372-920

Legal: LOT'S 160 BLOCK D.L. 2611 PLAN 21607

Address: 2453 KINNEY PLACE

Sanitary Connection: # 9358 SIZE 4" MATERIAL A.C. INV. 66.44 CONNECTED

Water Connection # 9358 SIZE 3/4" MATERIAL CU METER CONNECTED

Storm Connection: # SIZE MATERIAL INV. CONNECTED

Cash Receipt No's: WATER SANITARY STORM

CURB FROM PROPERTY LINE 4.877 m PAVEMENT WIDTH 10.363 m

B.C. HYDRO U/G UNDERGROUND CONNECTION

B.C. TELEPHONE U/G UNDERGROUND CONNECTION

INLAND GAS 3 m OFFSET AT EAST SIDE

Information Sheets:

Comments: WITH THAW WIRE;
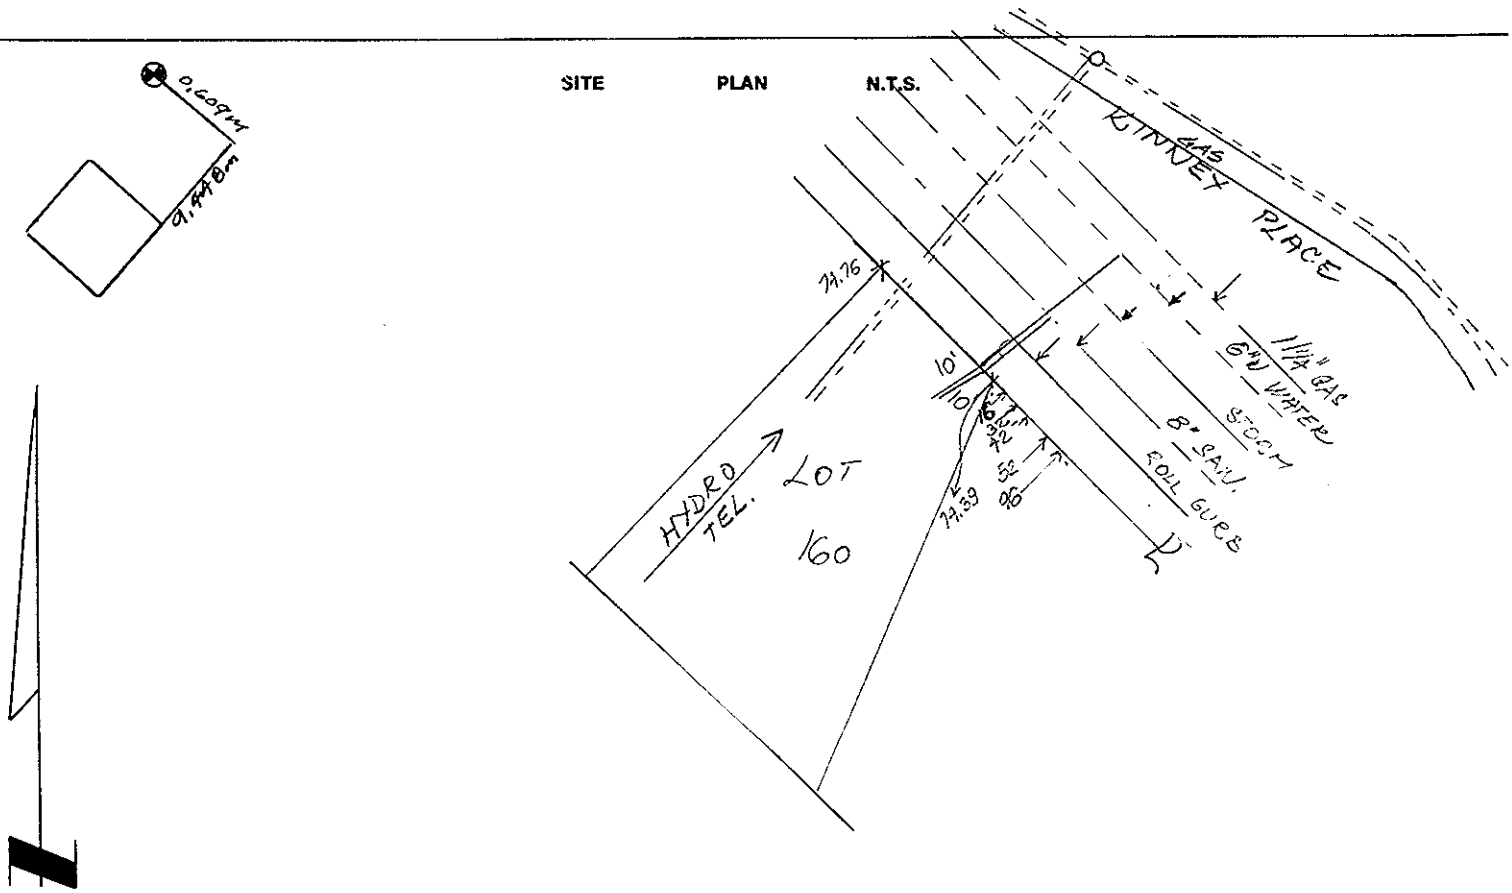
SITE PLAN N.T.S.