City of Prince George
HISTORY SHEET

FM

SHEET NUMBER № 1868 **Roll Number**

Legal: LOT'S BLOCK D.L. 4827 PLAN PGS80

Address: 392 KILLOREN CRES

Sanitary Connection: # 15013 SIZE 150mm MATERIAL INV. CONNECTED

Water Connection # 15013 SIZE 100mm MATERIAL METER CONNECTED

Storm Connection: # 1348 & 1349 SIZE 150 & 200mm MATERIAL INV. CONNECTED

Cash Receipt No's: WATER [illegible] SANITARY 5504 STORM 3505

CURB FROM PROPERTY LINE PAVEMENT WIDTH

B.C. HYDRO UNDERGROUND CONNECTION

B.C. TELEPHONE UNDERGROUND CONNECTION

INLAND GAS

Information Sheets:

Comments:
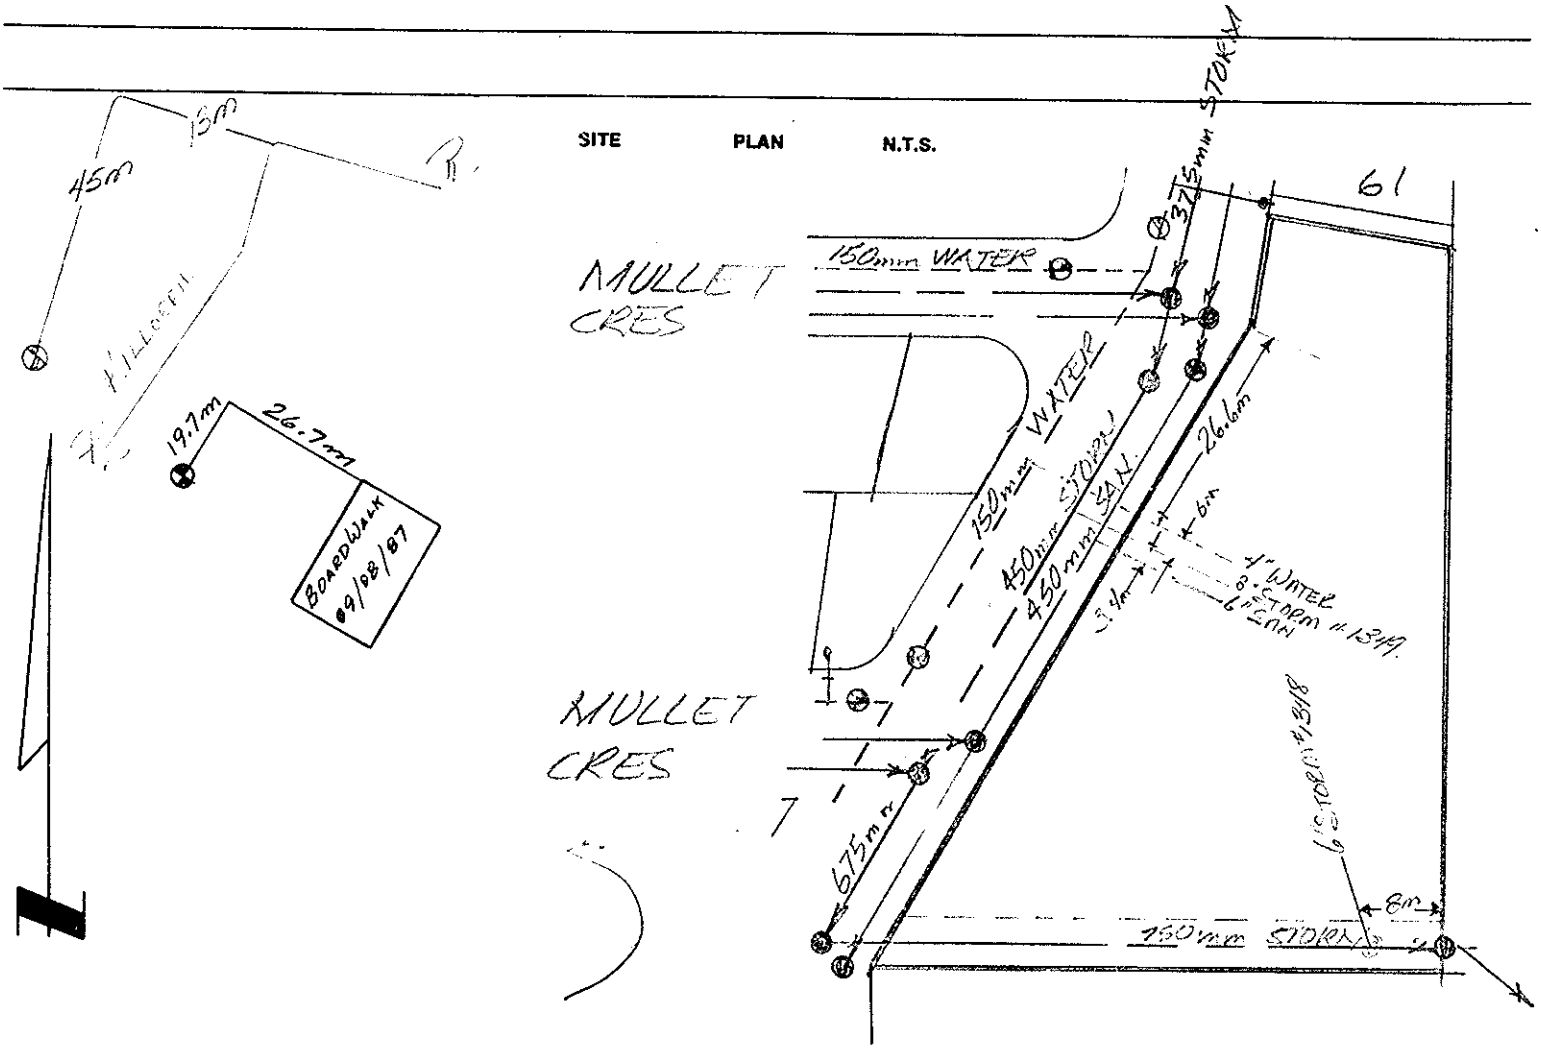
SITE PLAN N.T.S.