City of Prince George
HISTORY SHEET

SHEET NUMBER № 2868 **Roll Number** 004608-781

Legal: LOT'S 36 BLOCK D.L. 7634 PLAN 20138

Address: 2456 WINSTON RD.

Sanitary Connection: # SIZE 100mm MATERIAL P.V.C. INV. CONNECTED

Water Connection # SIZE 3/4" MATERIAL COPPER METER CONNECTED

Storm Connection: # SIZE MATERIAL INV. CONNECTED

Cash Receipt No's: WATER SANITARY STORM

CURB FROM PROPERTY LINE PAVEMENT WIDTH 8.00 m

B.C. HYDRO O/H UNDERGROUND CONNECTION

B.C. TELEPHONE O/H UNDERGROUND CONNECTION

INLAND GAS AS SHOWN

Information Sheets:

Comments: HID WATER SERVICE - 8' WEST OF EAST ℄ - IN LOT 36
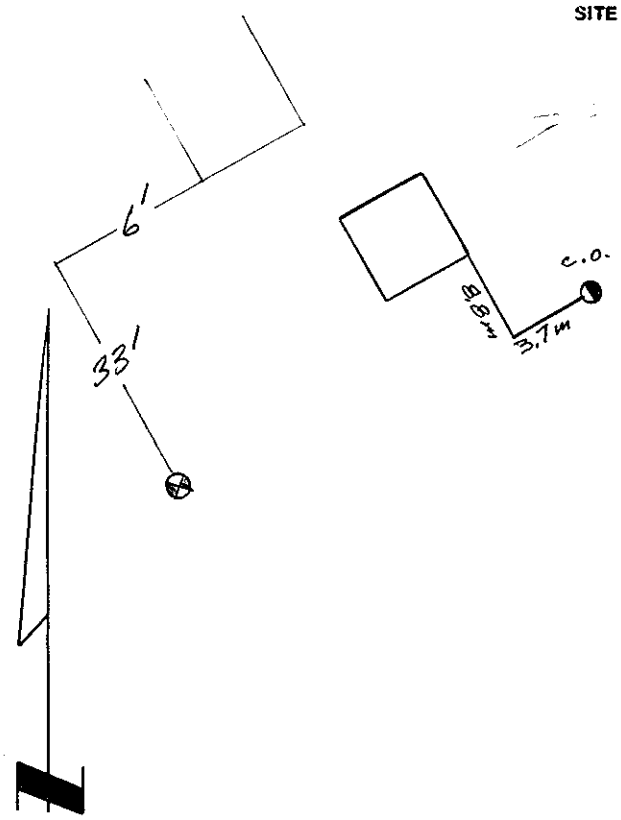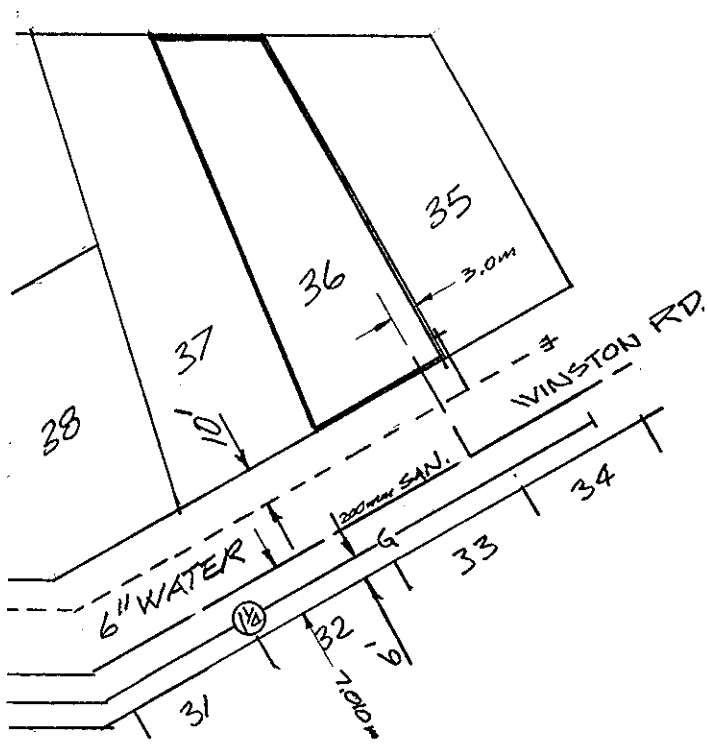
SITE PLAN N.T.S.