City of Prince George
HISTORY SHEET

SHEET NUMBER **Roll Number** 0046437221

Legal: LOT'S 72 BLOCK D.L. 1599 PLAN 13589

Address: 7305 EUGENE ROAD

Sanitary Connection: # 16247 SIZE 100mm MATERIAL INV. CONNECTED

Water Connection # 12192 SIZE 20mm MATERIAL Cu METER CONNECTED

Storm Connection: # SIZE MATERIAL INV. CONNECTED

Cash Receipt No's: WATER 2016 SANITARY STORM

CURB FROM PROPERTY LINE PAVEMENT WIDTH

B.C. HYDRO UNDERGROUND CONNECTION

B.C. TELEPHONE UNDERGROUND CONNECTION

INLAND GAS as shown

Information Sheets:

Comments:
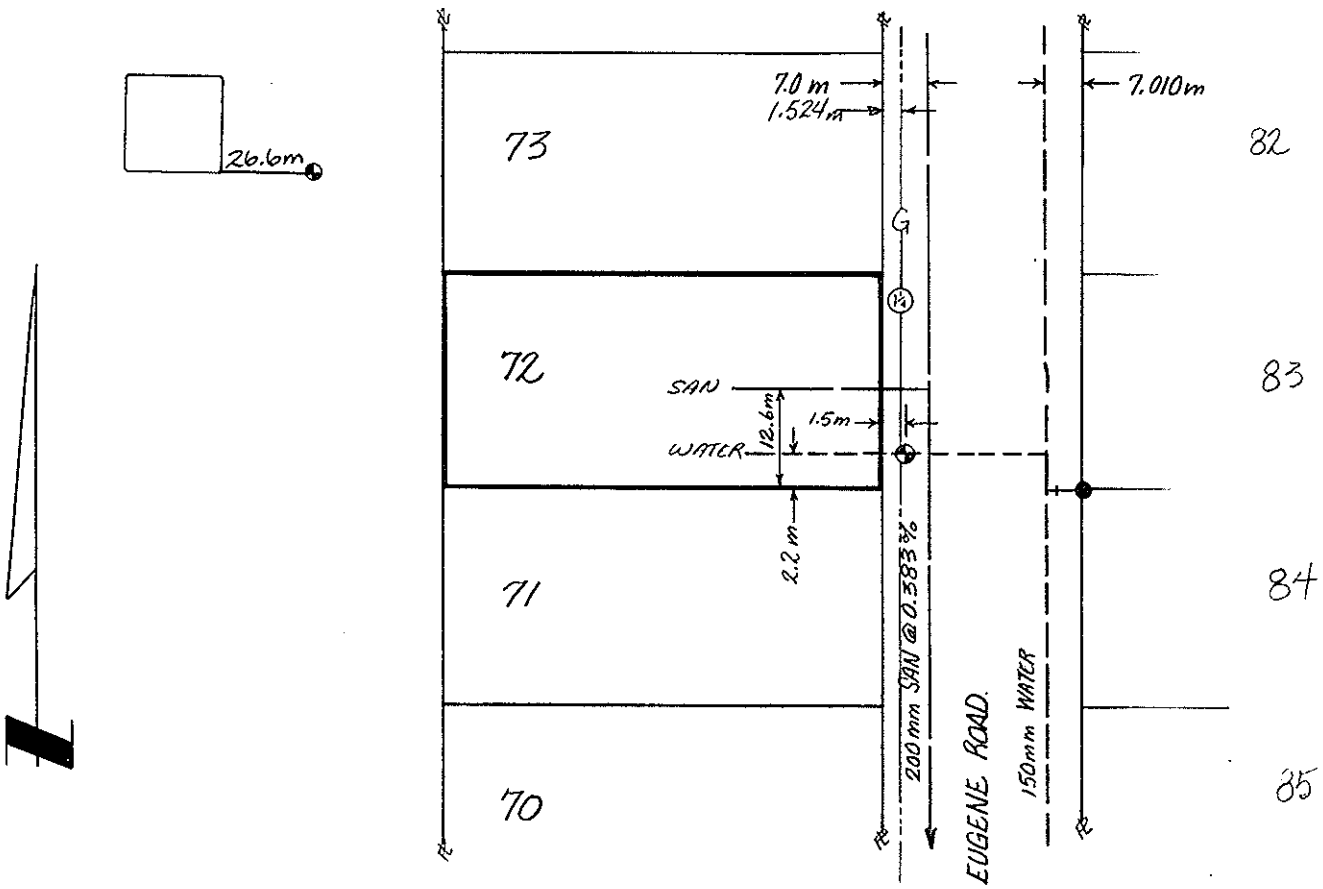
SITE PLAN N.T.S.