City of Prince George
HISTORY SHEET

004691334

SHEET NUMBER № 4821 **Roll Number** 342

Legal: LOT'S 21-22 BLOCK 2 D.L. 1429 PLAN 646

Address: 1372 DOUGLAS STREET

Sanitary Connection: # 179 SIZE MATERIAL INV. CONNECTED

Water Connection # 1299 SIZE 3/4" MATERIAL COPPER METER CONNECTED

Storm Connection: # SIZE MATERIAL INV. CONNECTED

Cash Receipt No's: WATER SANITARY STORM

CURB FROM PROPERTY LINE PAVEMENT WIDTH

B.C. HYDRO UNDERGROUND CONNECTION

B.C. TELEPHONE UNDERGROUND CONNECTION

INLAND GAS

Information Sheets:

Comments:
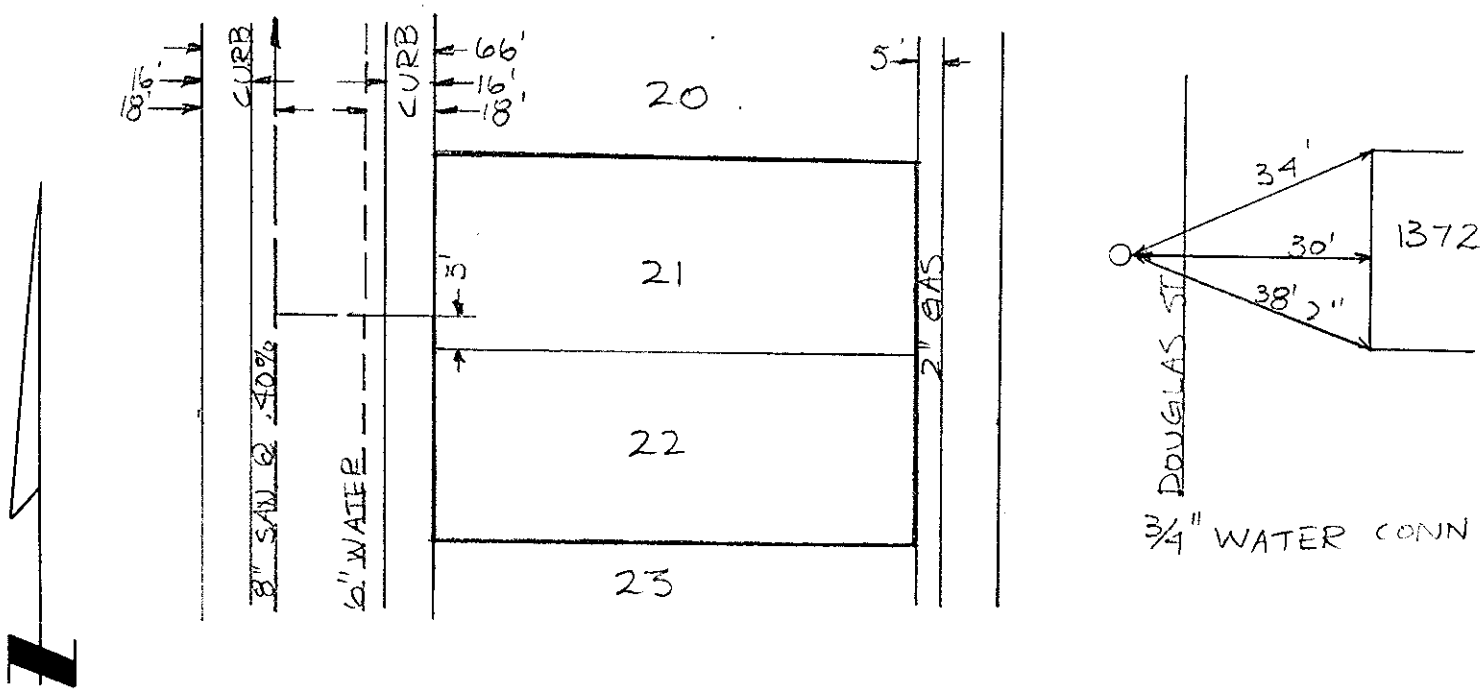
SITE PLAN N.T.S.