City of Prince George
HISTORY SHEET

SHEET NUMBER 11009 **Roll Number** 00469231

Legal: LOT'S 181 BLOCK D.L. 4377 PLAN 1329

Address: 1345 ABERDEEN RD.

Sanitary Connection: # 15219 1345 SIZE 100mm 100mm MATERIAL #2 INV. NOT GIVEN CONNECTED

Water Connection # 15219 SIZE 20mm 20mm MATERIAL #2 METER CONNECTED

Storm Connection: # SIZE MATERIAL INV. CONNECTED

Cash Receipt No's: WATER 644(#2) SANITARY 645(#2) STORM

CURB FROM PROPERTY LINE PAVEMENT WIDTH

B.C. HYDRO UNDERGROUND CONNECTION

B.C. TELEPHONE UNDERGROUND CONNECTION

INLAND GAS

Information Sheets:

Comments: NO INV. EL. - POST BROKEN OFF

THE INFORMATION CONTAINED HEREIN IS FOR INTERNAL USE ONLY. NOT TO BE RELIED UPON UNLESS CONFIRMED BY SITE INSPECTION AND/OR INVESTIGATION.
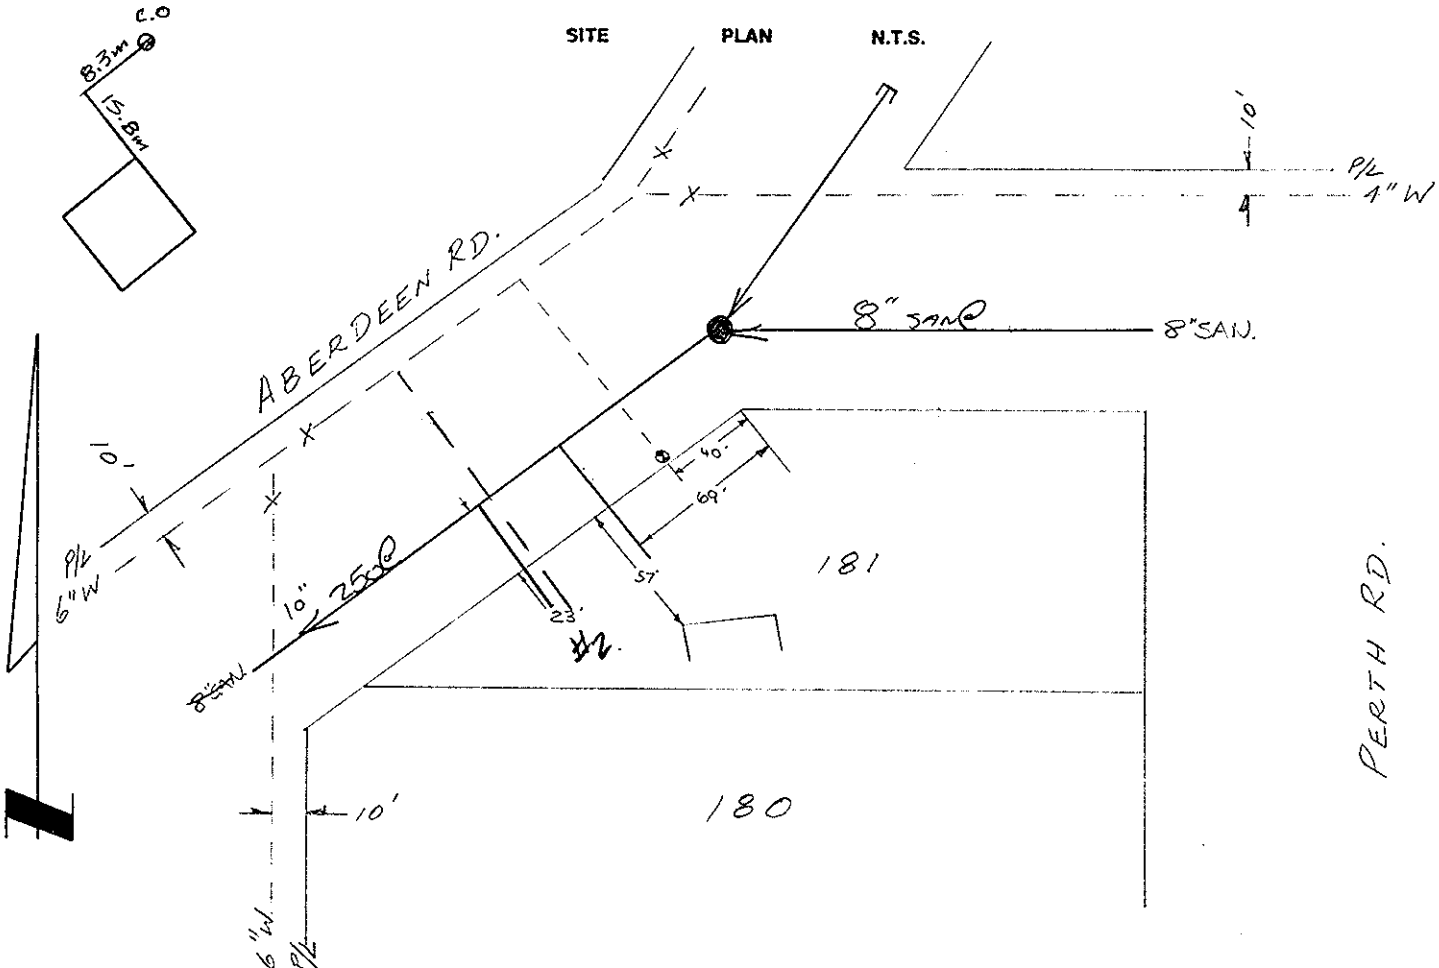
SITE PLAN N.T.S.