City of Prince George
HISTORY SHEET

009694989

SHEET NUMBER № 4780 **Roll Number** 937

Legal: LOT'S 1-2 BLOCK 1 D.L. 1429 PLAN 646.

Address: 2440 15th AVENUE

Sanitary Connection: # 1130 SIZE 4" MATERIAL AC. INV. CONNECTED

Water Connection # 2239 SIZE MATERIAL METER CONNECTED

Storm Connection: # SIZE MATERIAL INV. CONNECTED

Cash Receipt No's: WATER SANITARY STORM

CURB FROM PROPERTY LINE 12' PAVEMENT WIDTH 37'

B.C. HYDRO UNDERGROUND CONNECTION

B.C. TELEPHONE UNDERGROUND CONNECTION

INLAND GAS

Information Sheets:

Comments:

THE INFORMATION CONTAINED HEREIN IS FOR INTERNAL USE ONLY. NOT TO BE RELIED UPON UNLESS CONFIRMED BY SITE INSPECTION AND/OR INVESTIGATION.
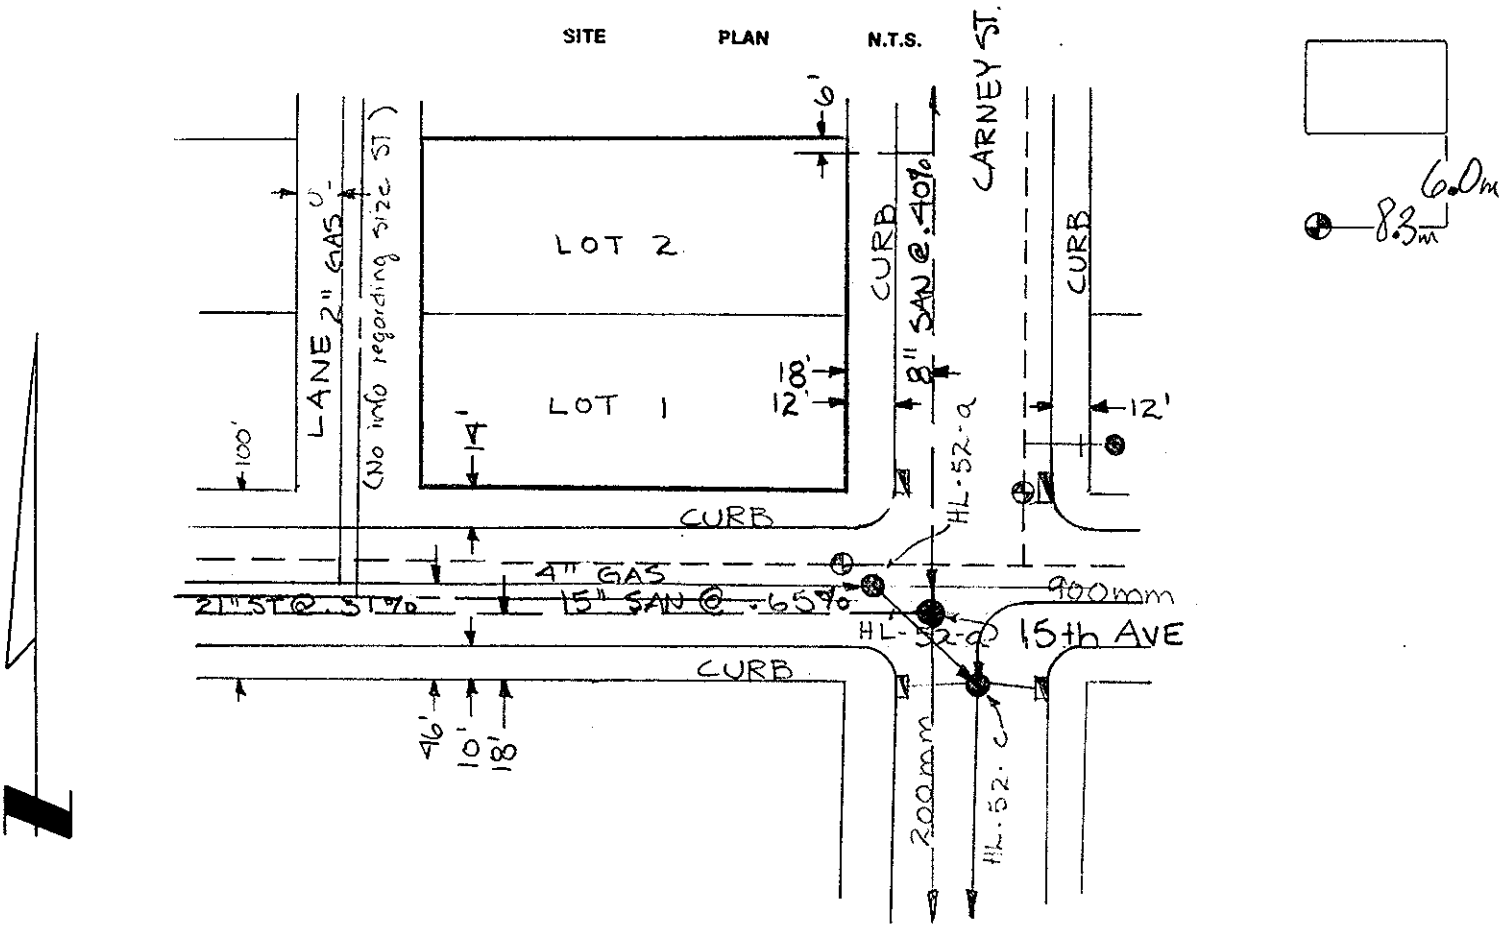
SITE PLAN N.T.S.