City of Prince George
HISTORY SHEET

00074220

SHEET NUMBER № 4891 **Roll Number** 946

Legal: LOT'S 7-8 BLOCK 6 D.L. 1429 PLAN 646

Address: 947 CARNEY STREET

Sanitary Connection: # 1025 SIZE MATERIAL INV. CONNECTED

Water Connection # 2277 SIZE 1/2" MATERIAL COPPER METER CONNECTED

Storm Connection: # SIZE MATERIAL INV. CONNECTED

Cash Receipt No's: WATER SANITARY STORM

CURB FROM PROPERTY LINE PAVEMENT WIDTH

B.C. HYDRO UNDERGROUND CONNECTION

B.C. TELEPHONE UNDERGROUND CONNECTION

INLAND GAS

Information Sheets:

Comments:
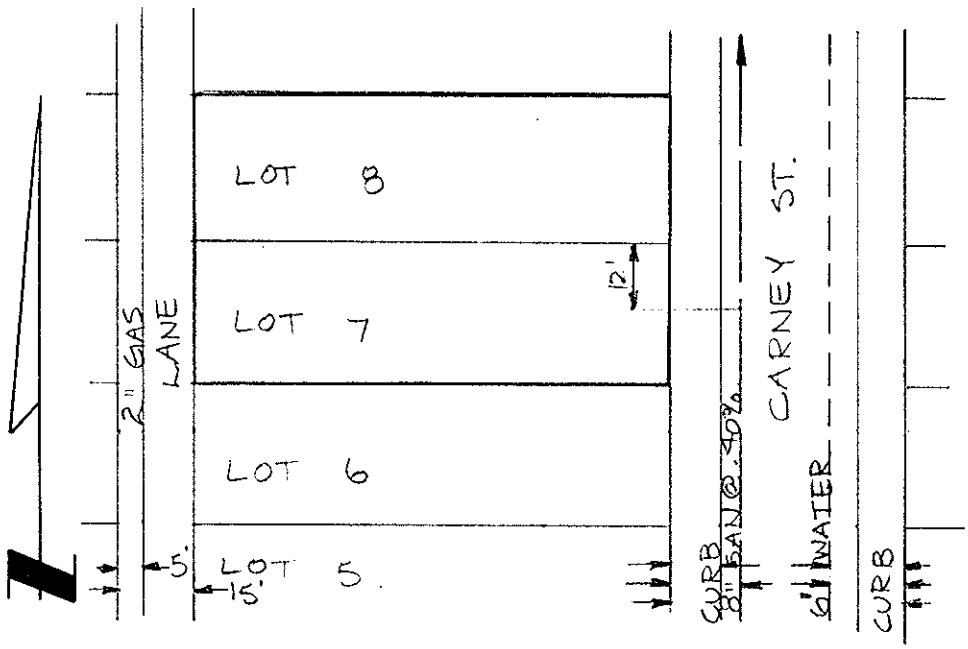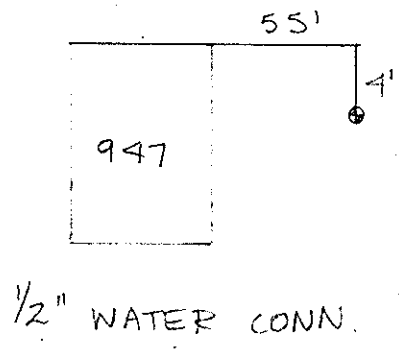
SITE PLAN N.T.S.