City of Prince George
HISTORY SHEET

3047/5004

SHEET NUMBER № 4890 **Roll Number** 012

Legal: LOT'S 5-6 BLOCK 6 D.L. 1429 PLAN 646

Address: 963 CARNEY STREET

Sanitary Connection: # 1014 SIZE MATERIAL INV. CONNECTED

Water Connection # 1330 SIZE ½" MATERIAL COPPER METER CONNECTED

Storm Connection: # SIZE MATERIAL INV. CONNECTED

Cash Receipt No's: WATER SANITARY STORM

CURB FROM PROPERTY LINE PAVEMENT WIDTH

B.C. HYDRO UNDERGROUND CONNECTION

B.C. TELEPHONE UNDERGROUND CONNECTION

INLAND GAS

Information Sheets:

Comments:

SITE PLAN N.T.S.

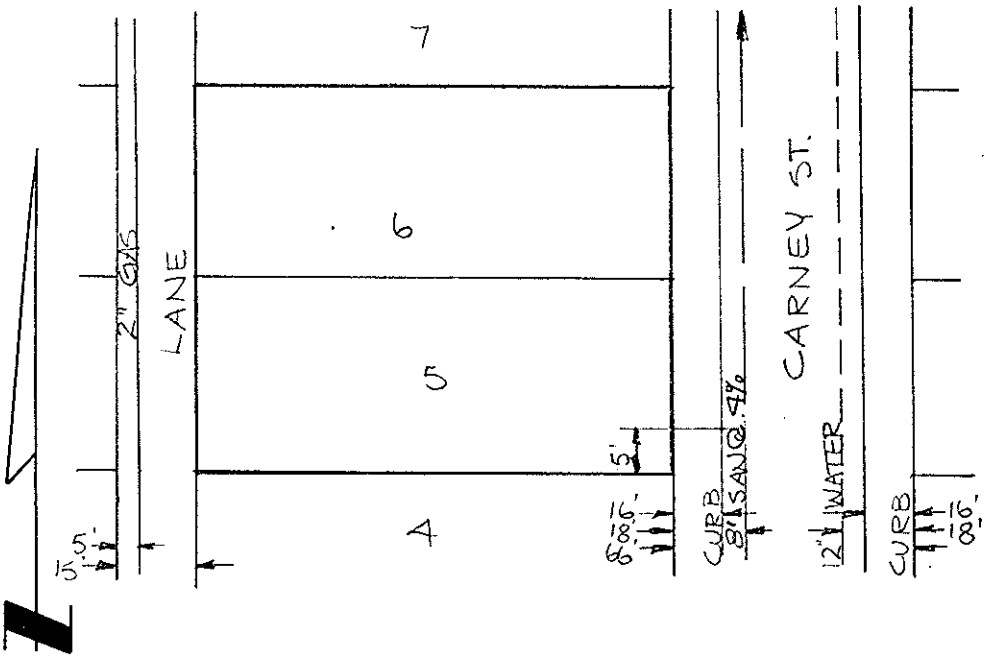

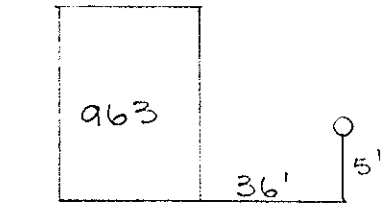

½" WATER CONN.