City of Prince George
HISTORY SHEET

004753585

SHEET NUMBER 6746 **Roll Number**

Legal: LOT'S 25 BLOCK D.L. 4047 PLAN 18801

Address: 7117 GLENVIEW DRIVE

Sanitary Connection: # 13546 SIZE 100mm MATERIAL P.V.C. INV. 30.190 CONNECTED

Water Connection # SIZE 3/4 MATERIAL Cu. METER CONNECTED

Storm Connection: # SIZE MATERIAL INV. CONNECTED

Cash Receipt No's: WATER SANITARY STORM

CURB FROM PROPERTY LINE PAVEMENT WIDTH

B.C. HYDRO UNDERGROUND CONNECTION

B.C. TELEPHONE UNDERGROUND CONNECTION

INLAND GAS

Information Sheets:

Comments: 1115 WATER SERVICE - 2.6' NORTH OF SOUTH PL

OWNER: AUDITTE JAMES 1-7-75
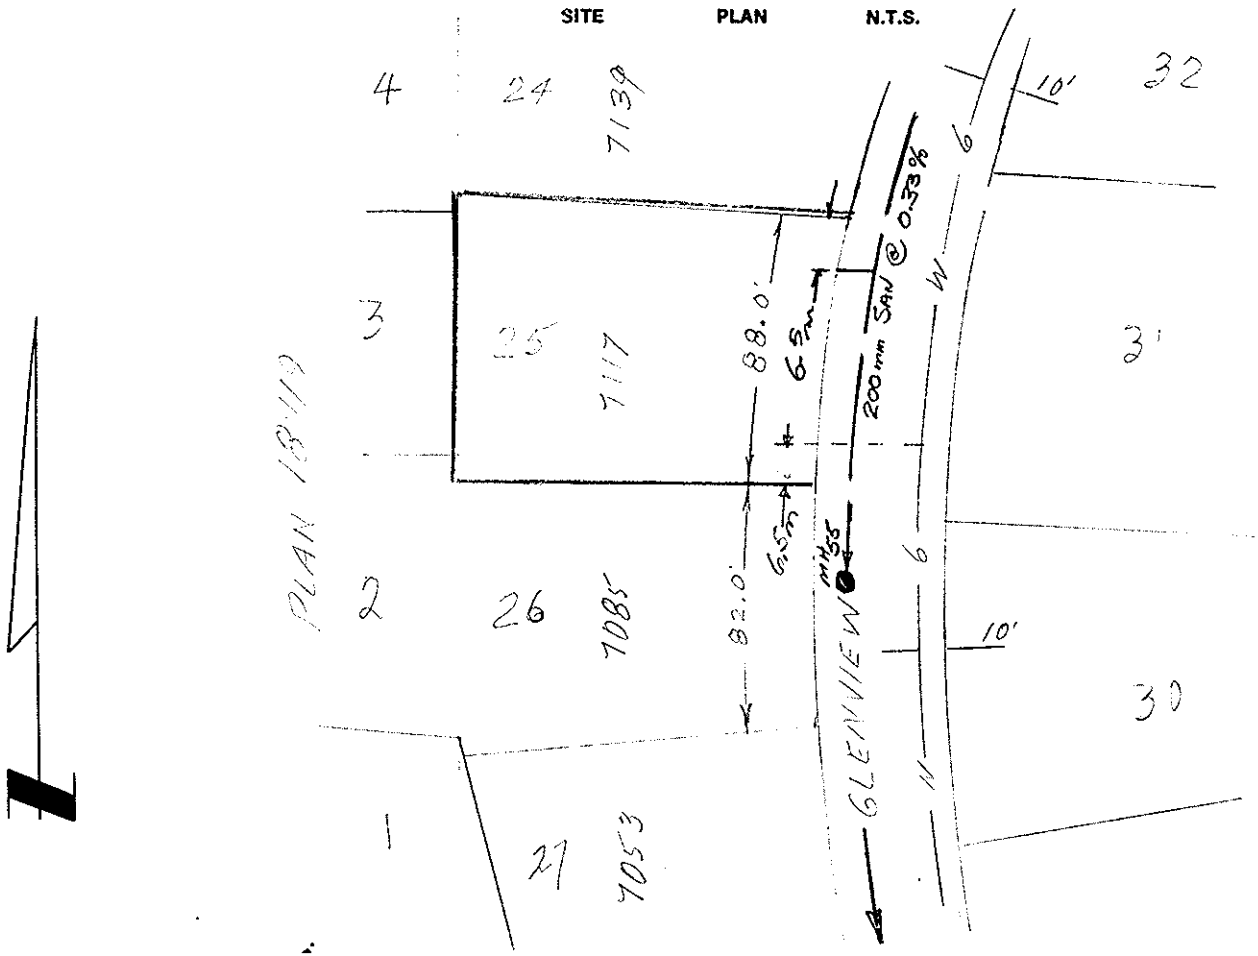
SITE PLAN N.T.S.