City of Prince George

HISTORY SHEET

004773853

SHEET NUMBER | PID #

Legal: LOT'S 216 BLOCK D.L. 936 PLAN 15185

Address: 1293 GARVIN ST.

Sanitary Connection: # 4714 SIZE 100 mm MATERIAL A.C. INV. CONNECTED

Water Connection: # 4714 SIZE 20 mm MATERIAL CU. METER CONNECTED

Storm Connection: # SIZE mm MATERIAL INV. CONNECTED

Cash Receipt No's: WATER PAID IN LOT PRICE SANITARY PAID IN LOT PRICE STORM

CURB FROM PROPERTY LINE 4.877 m PAVEMENT WIDTH 10.363 m

B.C. HYDRO U/G UNDERGROUND CONNECTION

B.C. TELEPHONE U/G UNDERGROUND CONNECTION

INLAND GAS AS SHOWN

Information Sheets:

Comments:
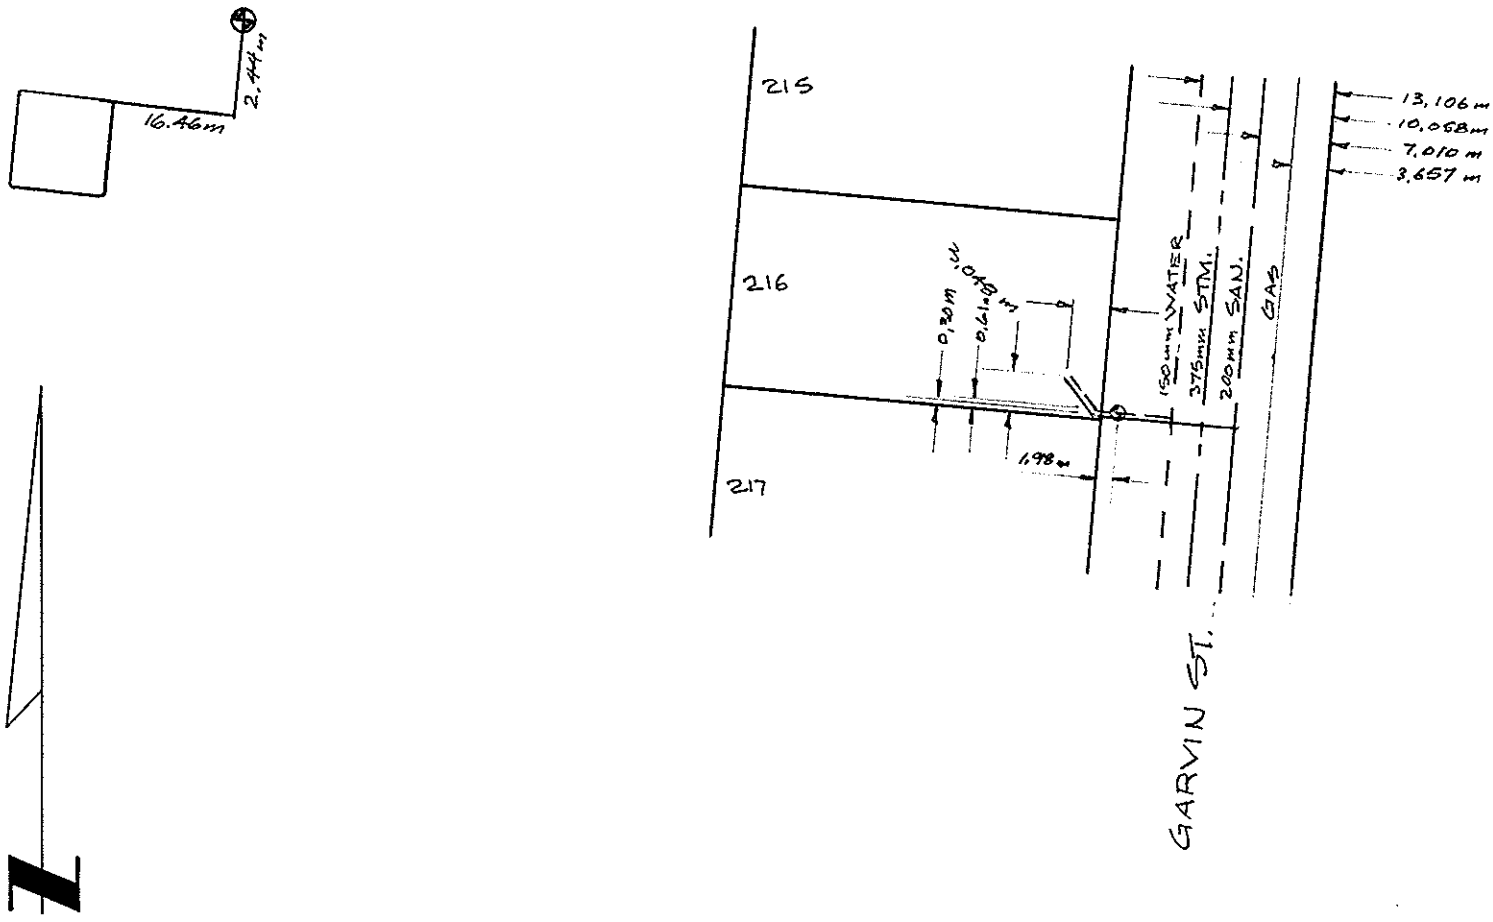
THE INFORMATION CONTAINED HEREIN IS FOR INTERNAL USE ONLY.
NOT TO BE RELIED UPON UNLESS CONFIRMED BY SITE INSPECTION AND/OR INVESTIGATION