City of Prince George
HISTORY SHEET

004945583

SHEET NUMBER № 4441 **Roll Number** 040

Legal: LOT'S 19-20 BLOCK 20 D.L. 1429 PLAN 646

Address: 960 - FREEMAN ST

Sanitary Connection: # 5005 SIZE 100mm MATERIAL A.C.S. INV. CONNECTED

Water Connection # 1488 SIZE 13mm MATERIAL METER CONNECTED

Storm Connection: # SIZE MATERIAL INV. CONNECTED

Cash Receipt No's: WATER SANITARY STORM

CURB FROM PROPERTY LINE PAVEMENT WIDTH

B.C. HYDRO UNDERGROUND CONNECTION

B.C. TELEPHONE UNDERGROUND CONNECTION

INLAND GAS

Information Sheets:

Comments:
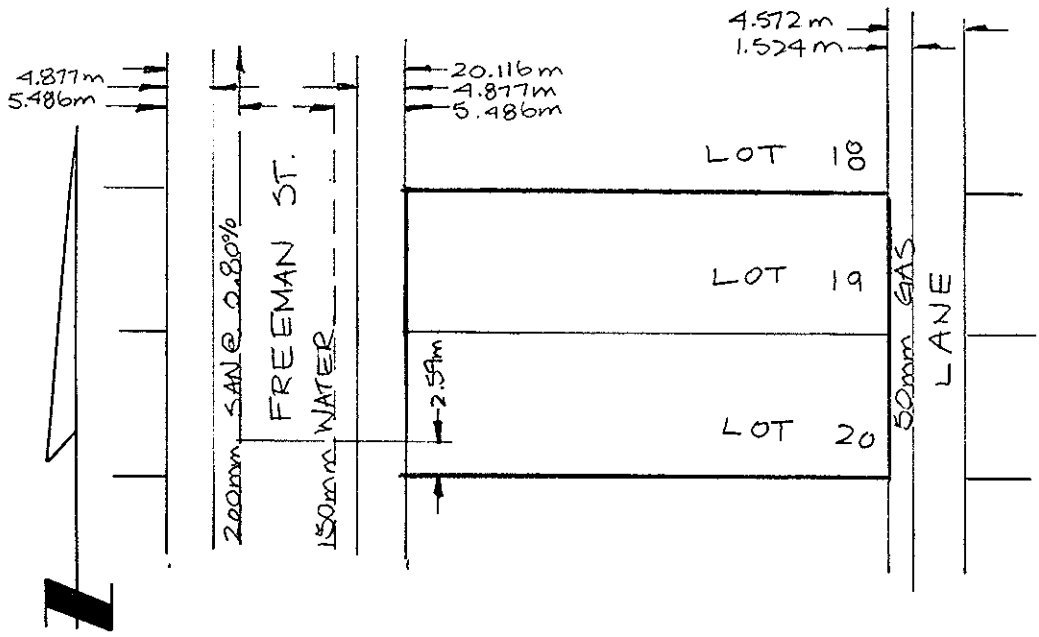
SITE PLAN N.T.S.