City of Prince George
HISTORY SHEET

SHEET NUMBER № 4434 **Roll Number**

Legal: LOT'S 3-4 BLOCK 20 D.L. 1429 PLAN 646

Address: 975 EWERT ST.

Sanitary Connection: # 4452 SIZE 100mm MATERIAL ACS INV. CONNECTED

Water Connection # 1482 SIZE 13mm MATERIAL COPPER METER CONNECTED

Storm Connection: # SIZE MATERIAL INV. CONNECTED

Cash Receipt No's: WATER SANITARY STORM

CURB FROM PROPERTY LINE PAVEMENT WIDTH

B.C. HYDRO UNDERGROUND CONNECTION

B.C. TELEPHONE UNDERGROUND CONNECTION

INLAND GAS

Information Sheets:

Comments:
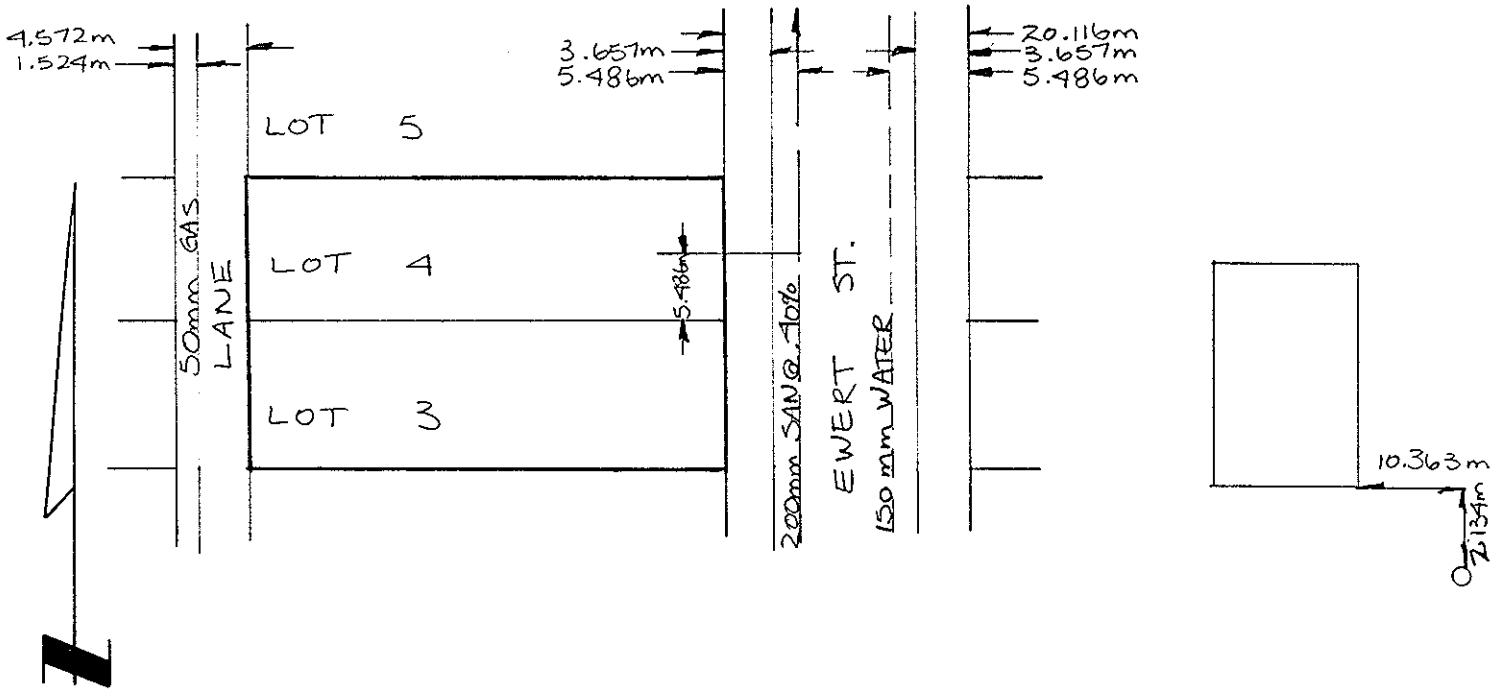
SITE PLAN N.T.S.