City of Prince George
HISTORY SHEET

SHEET NUMBER | **Roll Number**

Legal: LOT'S A BLOCK D.L. 2608 PLAN (21699) PGS 2.8

Address: 111 TABOR BLVD

	#	SIZE	MATERIAL	INV.	CONNECTED
Sanitary Connection:	9537 9538	200mm 200mm	AC AC		
Water Connection	9537 9538	150mm 150mm	AC AC	METER	
Storm Connection:	477 483 484	250mm 250mm 250mm	AC VIT VIT		

Cash Receipt No's: WATER SANITARY STORM 570 621 620

CURB FROM PROPERTY LINE PAVEMENT WIDTH

B.C. HYDRO UNDERGROUND CONNECTION

B.C. TELEPHONE UNDERGROUND CONNECTION

INLAND GAS

Information Sheets:

Comments:
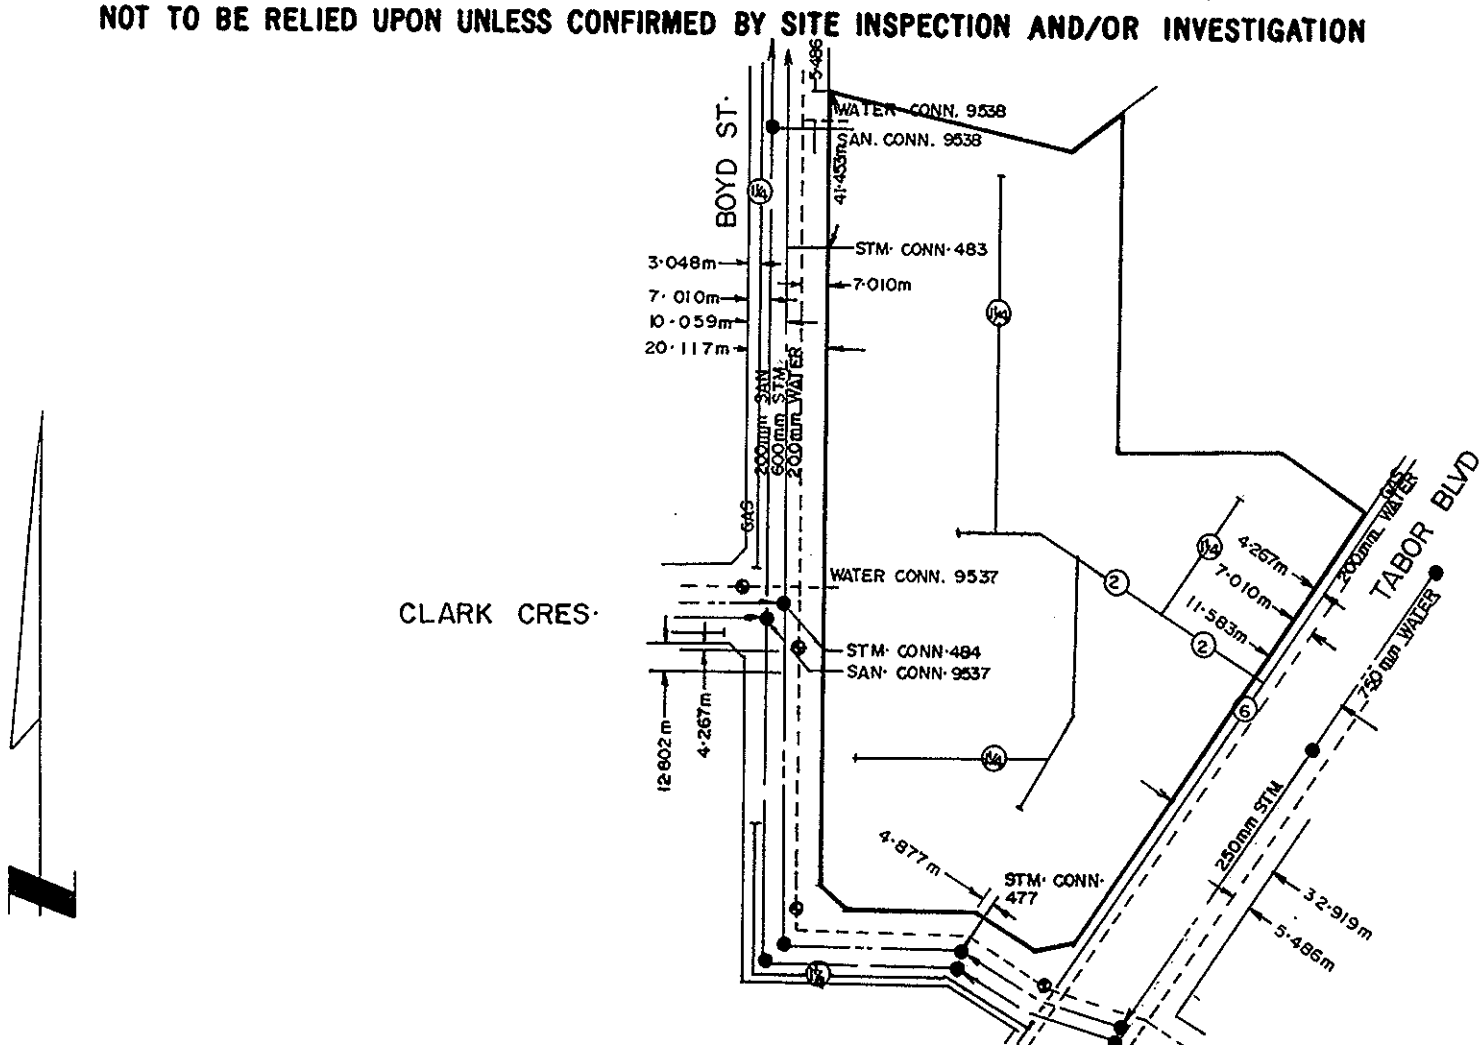
THE INFORMATION CONTAINED HEREIN IS FOR INTERNAL USE ONLY.
NOT TO BE RELIED UPON UNLESS CONFIRMED BY SITE INSPECTION AND/OR INVESTIGATION