City of Prince George
HISTORY SHEET

004861221

SHEET NUMBER № 4012 **Roll Number**

Legal: LOT'S 135 BLOCK D.L. 905 PLAN 24848

Address: 2863 CALHOUN CRES.

Sanitary Connection: # 12834 SIZE 100mm MATERIAL INV. CONNECTED

Water Connection # 12834 SIZE 19mm MATERIAL METER CONNECTED

Storm Connection: # 1310 SIZE 100mm MATERIAL INV. CONNECTED

Cash Receipt No's: WATER SANITARY STORM

CURB FROM PROPERTY LINE PAVEMENT WIDTH

B.C. HYDRO UNDERGROUND CONNECTION

B.C. TELEPHONE UNDERGROUND CONNECTION

INLAND GAS

Information Sheets:

Comments:
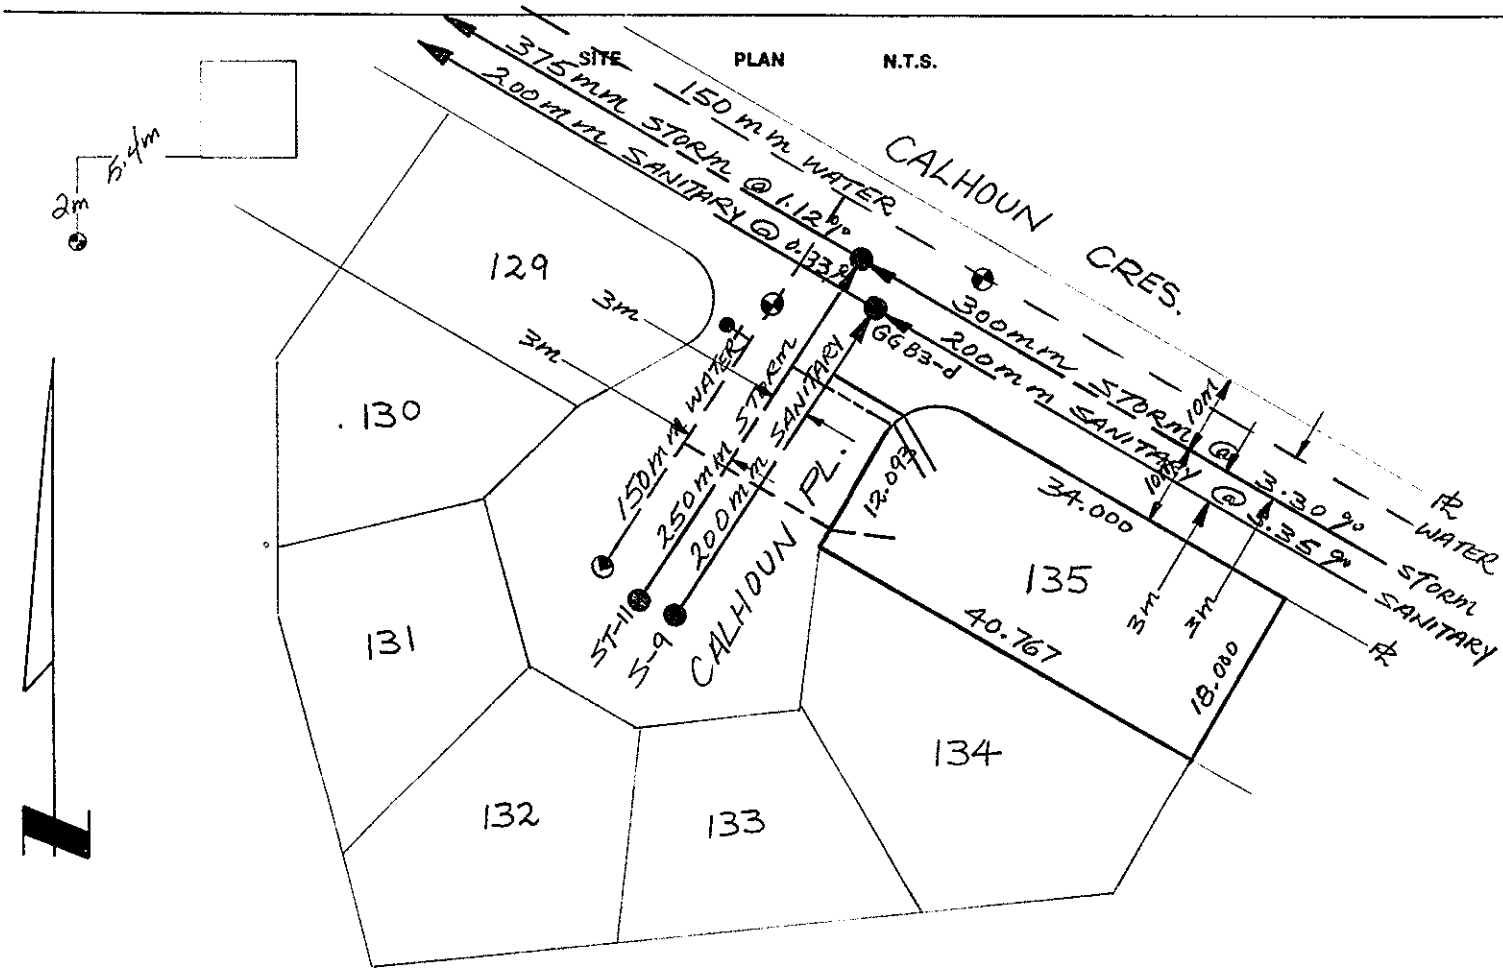
SITE PLAN N.T.S.