D. WYSE

City of Prince George
HISTORY SHEET

SHEET NUMBER **1633** Roll Number

Legal: LOT'S B BLOCK D.L. 343 PLAN 21843

Address: 1654 10th AVE.

Sanitary Connection: # 8980 SIZE 6" MATERIAL A.C. INV. 82.31 CONNECTED YES

Water Connection # 2221 8980 SIZE ½" 2" MATERIAL CU Cu METER CONNECTED YES

Storm Connection: # 468 SIZE 8" MATERIAL A.C. INV. 83.06 CONNECTED YES

Cash Receipt No's: WATER SANITARY 528 STORM 530

CURB FROM PROPERTY LINE 12' PAVEMENT WIDTH 42'

B.C. HYDRO O. H. UNDERGROUND CONNECTION

B.C. TELEPHONE O.H. UNDERGROUND CONNECTION

INLAND GAS IN LANE & 2" MAIN

Information Sheets:

Comments: BENCH MARK # 50-68 ELEVATION = 1893.76

S.I.P. S.E. CORNER 10th AND PRINCE RUPERT

LEVEL BOOK # 308-26
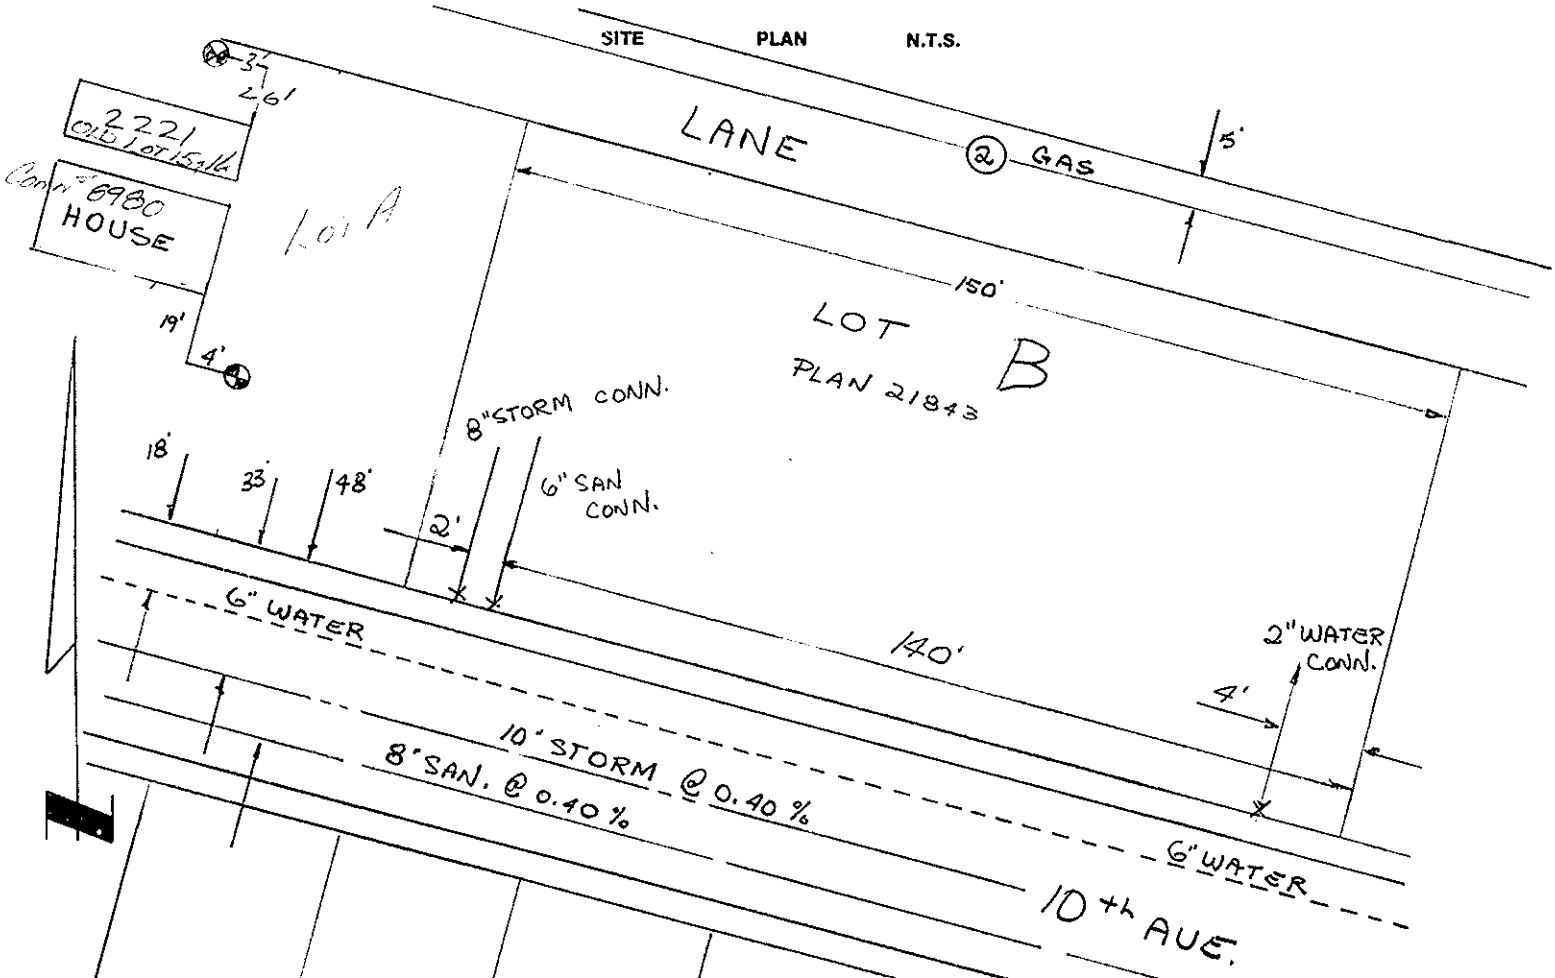
SITE PLAN N.T.S.