City of Prince George
HISTORY SHEET

SHEET NUMBER

Roll Number

Legal: LOT'S BLOCK D.L. 2507 PLAN PGS6

Address: 4288 15th Ave ASTRO VENTURES LTD.

Sanitary Connection: # 8905 SIZE 200mm MATERIAL vit INV. CONNECTED

Water Connection # 8905 SIZE 100mm MATERIAL cast METER CONNECTED 1973

Storm Connection: # 434 SIZE 300 MATERIAL vit INV. CONNECTED

Cash Receipt No's: WATER 313 SANITARY 312 STORM 311

CURB FROM PROPERTY LINE 3.048 m PAVEMENT WIDTH

B.C. HYDRO U/G UNDERGROUND CONNECTION

B.C. TELEPHONE U/G UNDERGROUND CONNECTION

INLAND GAS AS SHOWN

Information Sheets:

Comments:
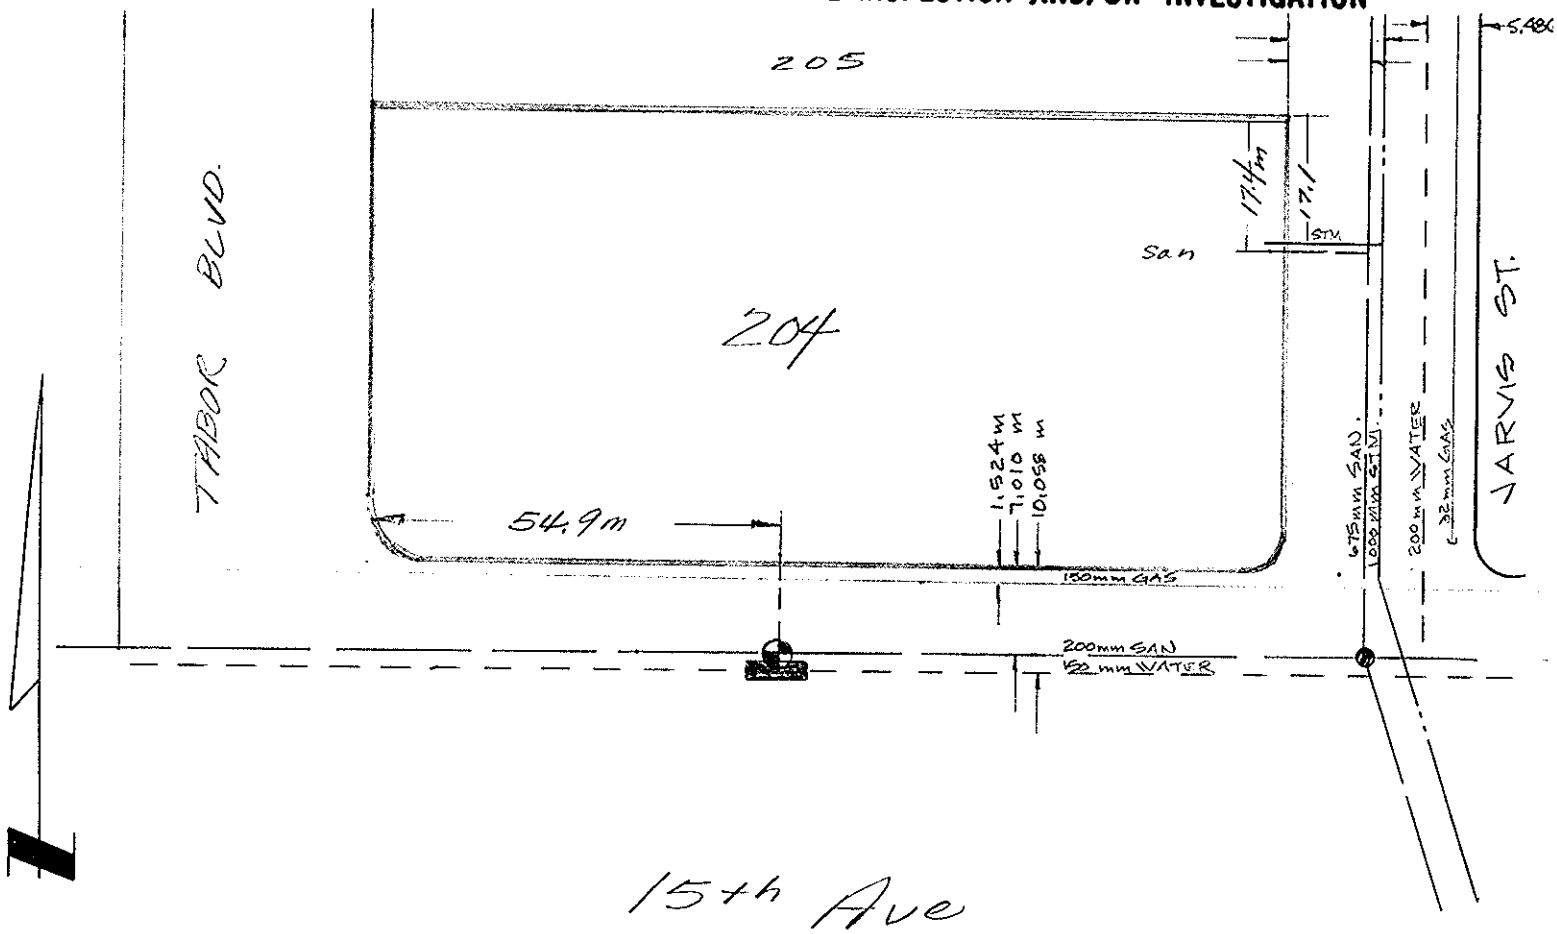
THE INFORMATION CONTAINED HEREIN IS FOR INTERNAL USE ONLY.
NOT TO BE RELIED UPON UNLESS CONFIRMED BY SITE INSPECTION AND/OR INVESTIGATION