City of Prince George Lot History Sheet

PID	Civic Address	Lot	Block	Plan	DL	Free Legal
PGS18	229 1ST AVE			PGS18	343	

	Size (mm)	Material	Invert @ PL	Cut @ PL	Survey Date	Field Book	Location	Comments
Sanitary	150ø	AC		1.8m				CONN# 11338
Water	40ø	CU						CONN # 11338
Storm	200ø	A.C		1.8m				CONN # 852
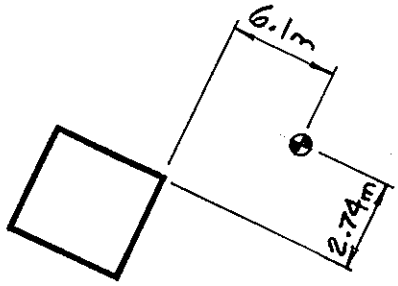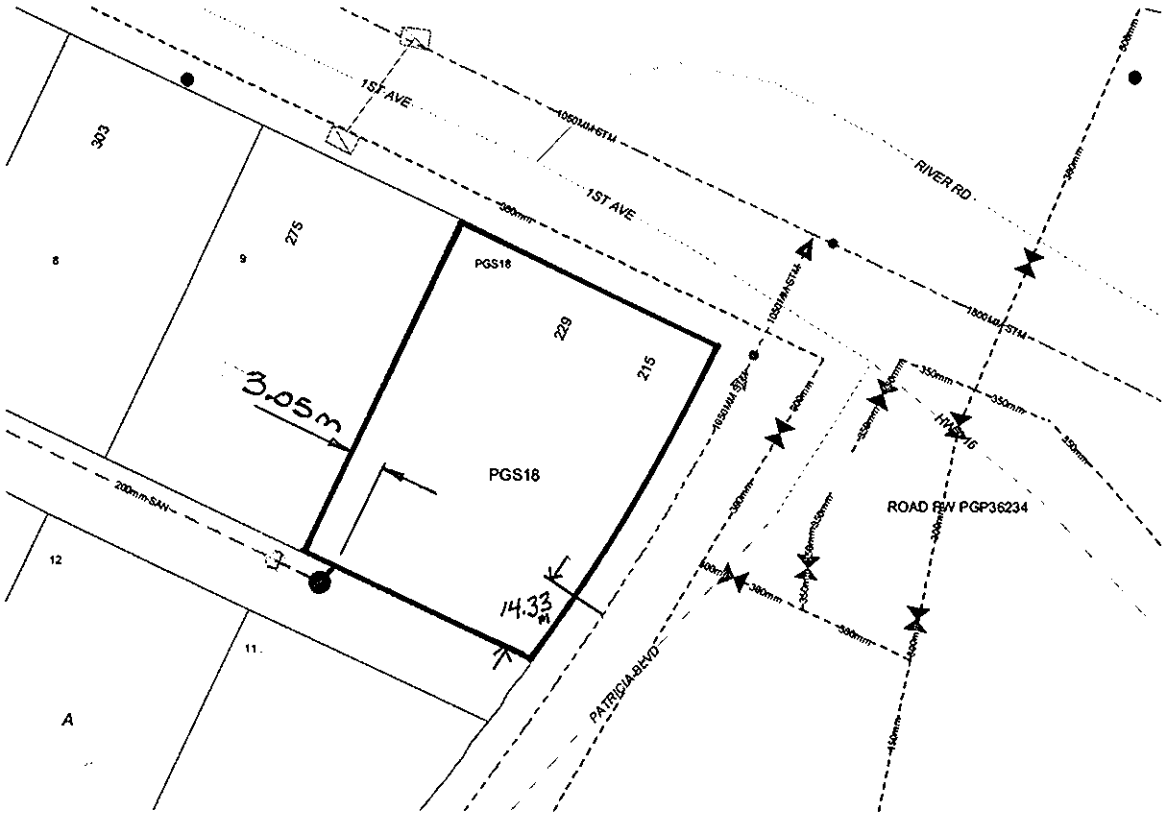
Accuracy Not Guaranteed Unless Confirmed By Site Inspection and/or Investigation.
Sketch is Oriented North (NTS)