City of Prince George
HISTORY SHEET

SHEET NUMBER 4583 **Roll Number** 004947789

Legal: LOT'S 174 BLOCK D.L. 482 PLAN 22883

Address: 325 MORAN CRES

Sanitary Connection: # 10595 SIZE 4" MATERIAL AC. INV. 15.07 CONNECTED

Water Connection # 10595 SIZE 3/4" MATERIAL Cu. METER CONNECTED

Storm Connection: # SIZE 4" MATERIAL ~~AC~~ P.V.C. INV. 15.58 CONNECTED

Cash Receipt No's: WATER SANITARY STORM

CURB FROM PROPERTY LINE 16' PAVEMENT WIDTH 34'

B.C. HYDRO UNDERGROUND CONNECTION

B.C. TELEPHONE UNDERGROUND CONNECTION

INLAND GAS

Information Sheets:

Comments: B.M. # 1382 ELEV. 2019.98 H.S.N.E. CORNER MORAN & OLIVER

LEVEL BOOK 333
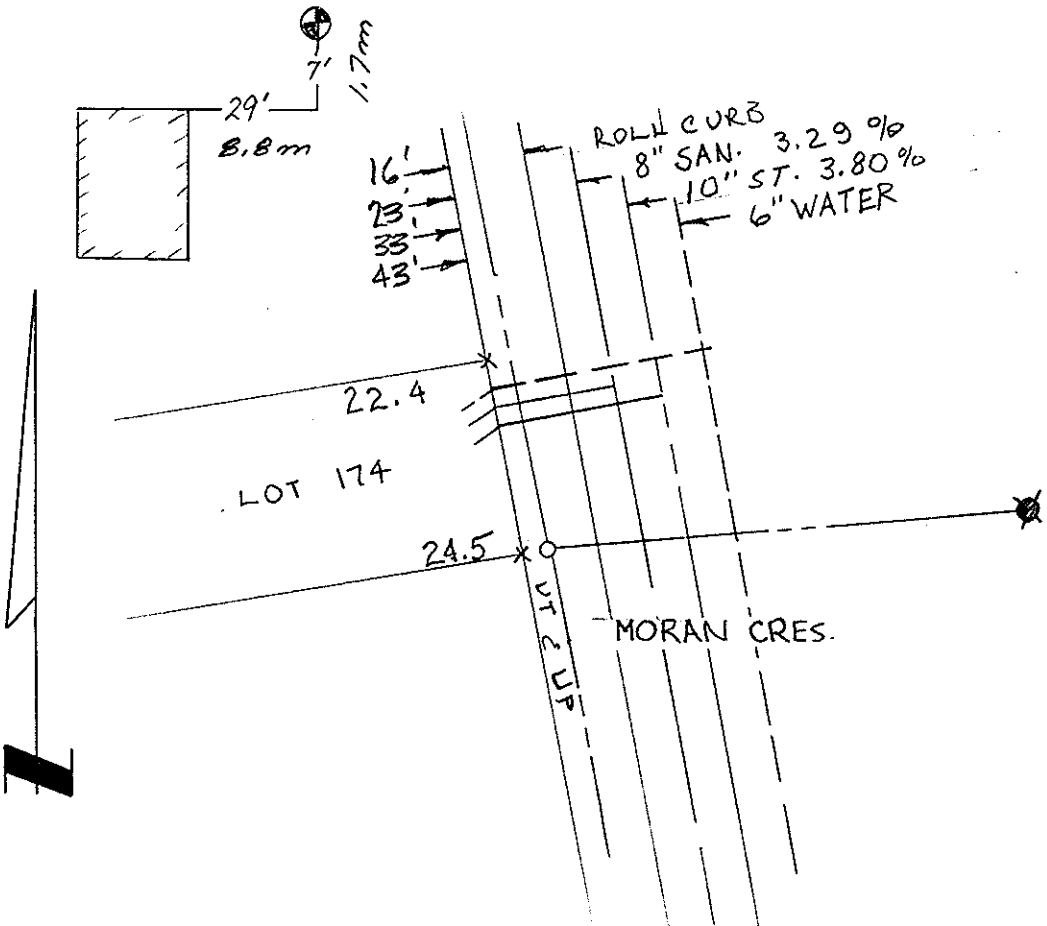
SITE PLAN N.T.S.