City of Prince George
HISTORY SHEET

Installation Date: MAY 1968 **PID:** 004953827

Legal: Lot 14 **Blk:** **DL:** 957 **PL:** 9675

Address: 586 N Blackburn Road

Fibreoptics				**Depth:**	**Connected:**	N
Sanitary Connection #:	11053	**Size:**	100mm	**Material:** PVC	**Depth:**	**Connected:** Y
Water Connection #:	BID	**Size:**	20mm	**Material:**	**Depth:**	**Connected:** Y
Storm Connection #:		**Size:**		**Material:**	**Depth:**	**Connected** N

Cash Receipt Nos: **Water** May 1968 **Sanitary** Dec 1976 **Storm**

Curb from Property Line **Pavement Width**
Shaw
BC Hydro **U/G Connection**
Telus **U/G Connection**
Terasen
Information Sheets:
Comments: Sanitary service location not confirmed
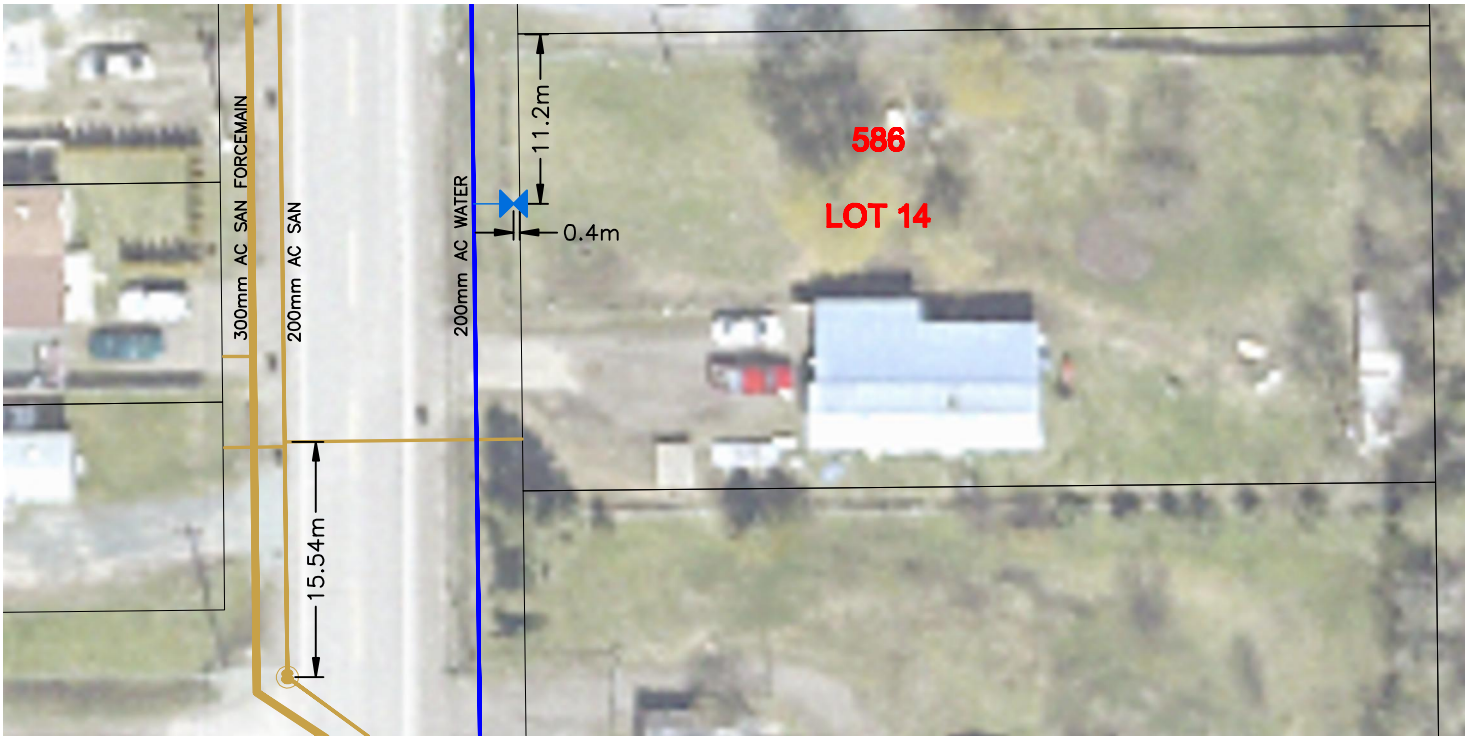
The information contained herein is for internal use only. Not to be relied upon unless confirmed by site inspection and/or investigation.