City of Prince George
HISTORY SHEET

SHEET NUMBER | PID #

Legal: LOT'S | BLOCK | D.L. 1427 | PLAN PGS12

Address: 4051 McRAE AVE ; 199 N OSPIKA BLVD

Sanitary Connection: # | SIZE | mm | MATERIAL | INV. | CONNECTED

Water Connection: # | SIZE | mm | MATERIAL | METER | CONNECTED

Storm Connection: # | SIZE | mm | MATERIAL | INV. | CONNECTED

Cash Receipt No's: WATER | SANITARY | STORM

CURB FROM PROPERTY LINE | PAVEMENT WIDTH

B.C. HYDRO | UNDERGROUND CONNECTION

B.C. TELEPHONE | UNDERGROUND CONNECTION

INLAND GAS

Information Sheets:

Comments:
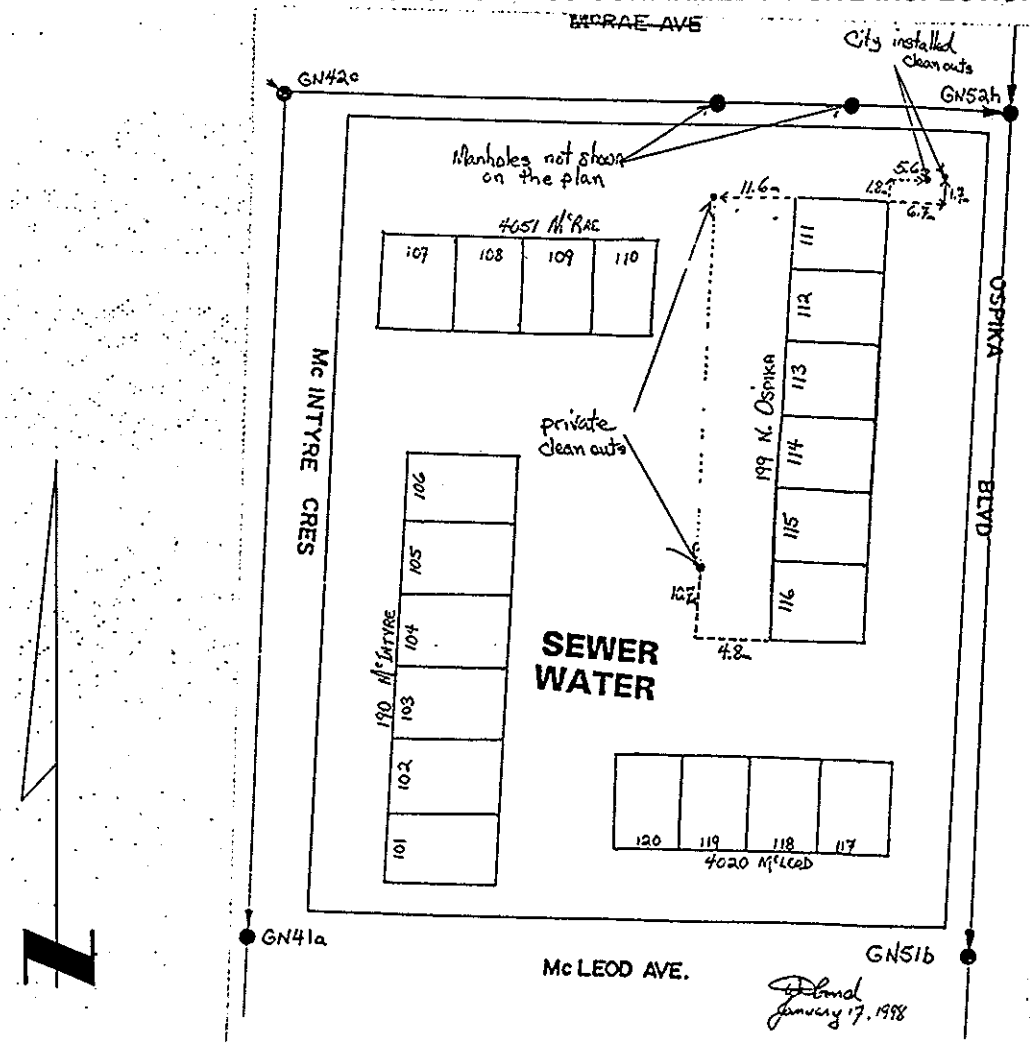
THE INFORMATION CONTAINED HEREIN IS FOR INTERNAL USE ONLY.
NOT TO BE RELIED UPON UNLESS CONFIRMED BY SITE INSPECTION AND/OR INVESTIGATION