City of Prince George
HISTORY SHEET

SHEET NUMBER **Roll Number** (PG15)

Legal: LOT'S REM 68 BLOCK D.L. 8171 PLAN 19517

Address: 2550 OSPIKA BLVD

Sanitary Connection: # 10178 / 9144 SIZE 200mm/150mm MATERIAL AC / AC INV. CONNECTED

Water Connection # 9144 / 10178 SIZE 50mm/100mm MATERIAL Cu / Cast. METER CONNECTED

Storm Connection: # 562 / 478 SIZE 300mm/200mm MATERIAL AC / AC INV. CONNECTED

Cash Receipt No's: WATER 691 / 807 SANITARY 808 / 690 STORM 809 / 692

CURB FROM PROPERTY LINE PAVEMENT WIDTH

B.C. HYDRO UNDERGROUND CONNECTION

B.C. TELEPHONE UNDERGROUND CONNECTION

INLAND GAS

Information Sheets:

Comments:

The information contained herein is for internal use only. Not to be relied upon unless confirmed by site inspection and/or investigation.
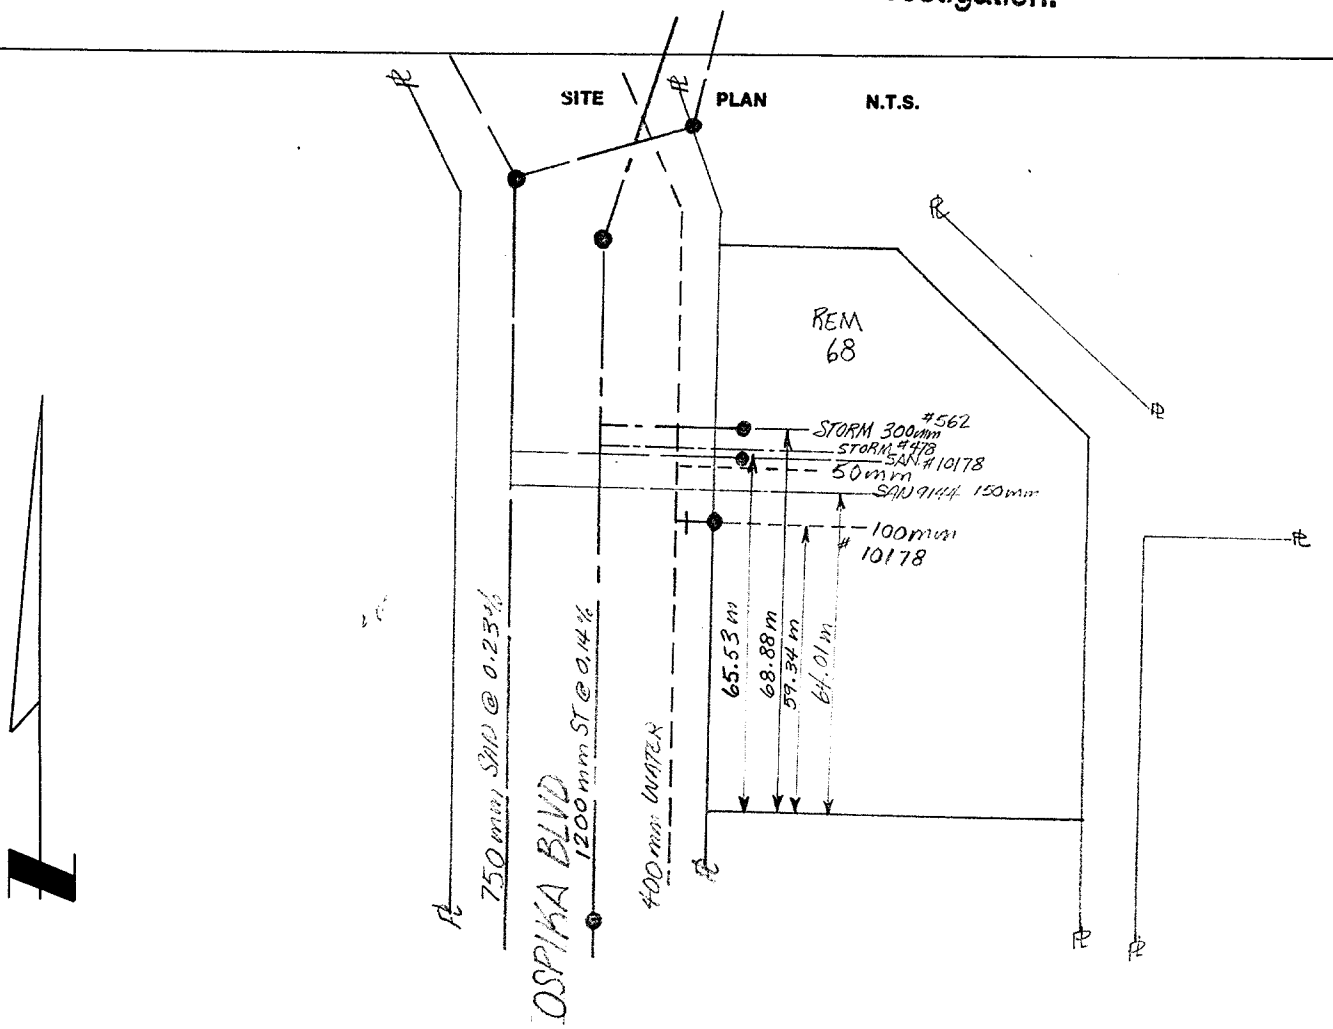
SITE PLAN N.T.S.