City of Prince George
HISTORY SHEET

SHEET NUMBER **Roll Number**

Legal: LOT'S BLOCK D.L. 1574 PLAN PGS 19

Address: 595 ONGMAN ROAD

Sanitary Connection: # 11437 SIZE 6" MATERIAL A.C. INV. CONNECTED

Water Connection # 11437 SIZE 2" MATERIAL COPPER METER CONNECTED

Storm Connection: # SIZE MATERIAL INV. CONNECTED

Cash Receipt No's: WATER 0636 SANITARY 0635 STORM

CURB FROM PROPERTY LINE PAVEMENT WIDTH

B.C. HYDRO UNDERGROUND CONNECTION

B.C. TELEPHONE UNDERGROUND CONNECTION

INLAND GAS

Information Sheets:

Comments:

The information contained herein is for internal use only. Not to be relied upon unless confirmed by site inspection and/or investigation.
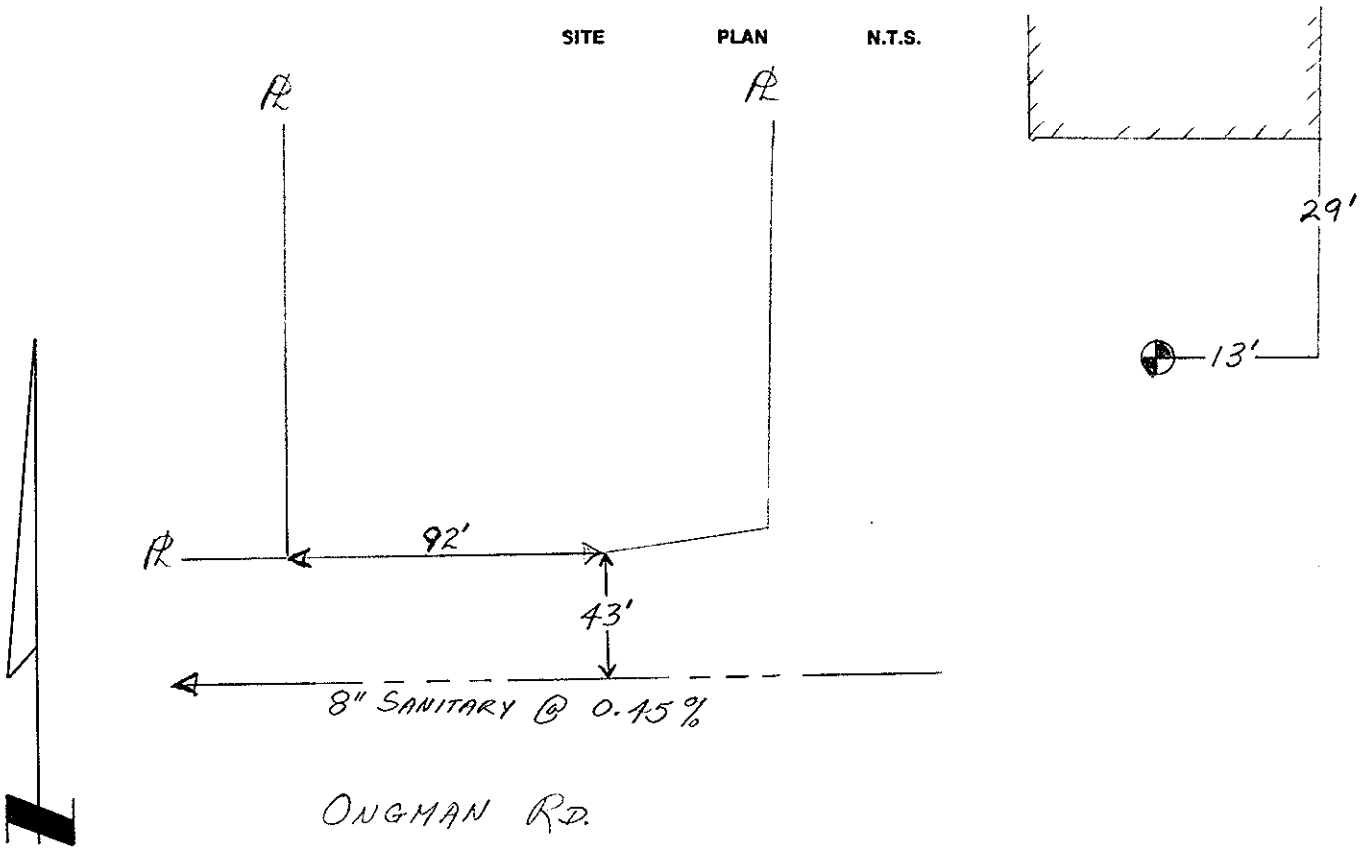
SITE PLAN N.T.S.