City of Prince George
HISTORY SHEET

SHEET NUMBER 7101 **Roll Number** 005077192

Legal: LOT'S 42 BLOCK D.L. 4048 PLAN 20605

Address: 4690 ~~2716~~ CROCUS CRESCENT South

Sanitary Connection: # 15619 SIZE 100 MM MATERIAL PVC INV. CONNECTED

Water Connection # SIZE 3/4" 20MM MATERIAL CU METER CONNECTED

Storm Connection: # SIZE MATERIAL INV. CONNECTED

Cash Receipt No's: WATER SANITARY STORM

CURB FROM PROPERTY LINE PAVEMENT WIDTH

B.C. HYDRO UNDERGROUND CONNECTION

B.C. TELEPHONE UNDERGROUND CONNECTION

INLAND GAS

Information Sheets:

Comments: NID WATER SERVICE - 12' SOUTH OF NORTH CORNER

OWNER: BEALEY RONALD VICTOR
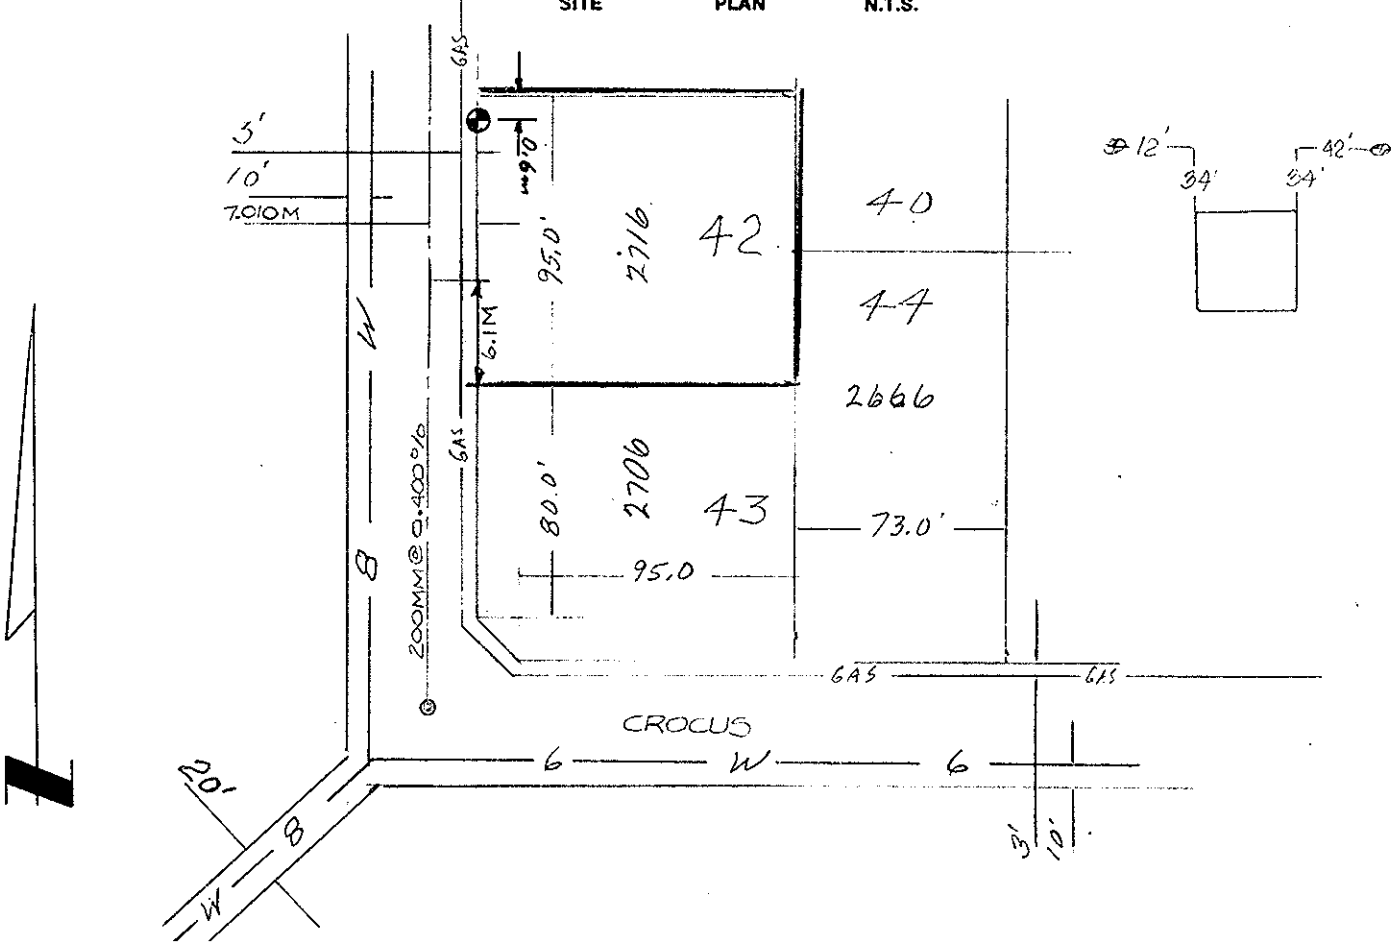
SITE PLAN N.T.S.